

Stone
B 2011
10/18/77

MISSISSIPPI
BOARD OF WATER COMMISSIONERS
416 North State Street
Jackson, Mississippi 39201

WATER WELL DRILLERS LOG

20-18 1977 *Gene Anderson* Stone
date well completed firm name county well located

LANDOWNER:	description of formations encountered	from	to
<i>Dr. Ratliff</i>			
(mailing address)	<i>Red Clay</i>	<i>3</i>	<i>31</i>
WELL LOCATION:	<i>Course Sand</i>	<i>31</i>	<i>105</i>
sec <i>25</i> T <i>2</i> N R <i>12</i> E S W			
<i>1/2</i> miles <i>W</i> of <i>W. Logan</i> (distance) (direction) (nearest town)			
WELL PURPOSE: <i>HOME</i> (home, irrigation, municipal, industrial)			
WELL COMPLETION DATA:			
(1) diameter (inches) <i>2"</i>			
(2) total depth (feet) <i>105'</i>			
(3) static water level (feet) <i>36'</i> below top of ground.			
(4) casing <i>Plastic, 100'</i> (material) (depth)			
(size) if telescope see back.			
(5) screen <i>5' 100'</i> (length) (depth to top)			
<i>2" Plastic</i> (size) (material)			
(6) pump <i>1</i> <i>8</i> (HP) (yield gpm)			
<i>Elect</i> (type power)			
(7) electric log <i>no</i> (yes or no)			
(organization running log)			
(8) how well bottom plugged <i>Capped</i>			
DRILLERS REMARKS:			


RECEIVED

NOV - 8 1977

MISS. BD. OF WATER COMM

If well telescopes please sketch and show depths.

GROUND LEVEL

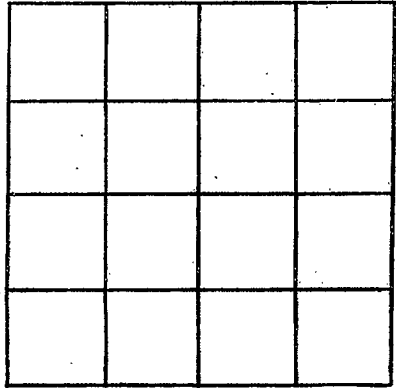

SECTION _____

Please indicate well location X.

ADDITIONAL INFORMATION

If more than one screen,
show locations of each on sketch.