

STONE
 B
 2012
 5-2-18

MISSISSIPPI
 BOARD OF WATER COMMISSIONERS
 416 North State Street
 Jackson, Mississippi 39201

WATER WELL DRILLERS LOG


5-2 1978 Pinnell Anderson Stone
 date well completed firm name county well located

LANDOWNER:	description of formations encountered	from	to
<u>Thomas Jellison</u>	<u>Top Soil</u>	<u>0</u>	<u>2</u>
(mailing address)	<u>Course Land</u>	<u>2</u>	<u>75</u>
WELL LOCATION: sec. <u>11</u> T. <u>2</u> S. R. <u>12</u> <u>0</u> miles (distance) <u>0</u> (direction) of <u>Bond</u> (nearest town)			
WELL PURPOSE: <u>HOME</u> (home, irrigation, municipal, industrial)			
WELL COMPLETION DATA:			
(1) diameter (inches) <u>2"</u>			
(2) total depth (feet) <u>75'</u>			
(3) static water level (feet) <u>35'</u> below top of ground			
(4) casing <u>Plastic</u> (material) <u>70'</u> (depth)			
(size) if telescope see back.			
(5) screen <u>5'</u> (length) <u>70'</u> (depth to top)			
<u>2"</u> (size) <u>Plastic</u> (material)			
(6) pump <u>1</u> (HP) <u>11</u> (yield gpm)			
<u>Elect</u> (type power)			
(7) electric log <u>NO</u> (yes or no)			
(organization running log)			
(8) how well bottom plugged <u>Capped</u>			
DRILLERS REMARKS:			

RECEIVED
 JUN - 2 1978

If well telescopes please sketch and show depths.

GROUND LEVEL

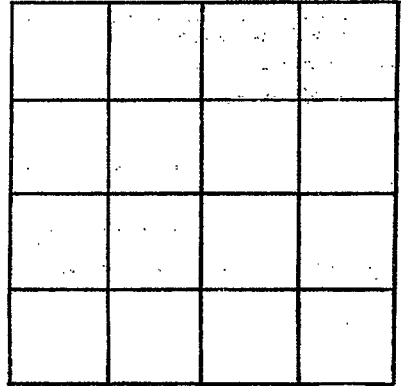

SECTION _____

Please indicate well location X.

ADDITIONAL INFORMATION

If more than one screen, show locations of each on sketch.