

STONE  
B 2015  
09-20-78

MISSISSIPPI  
BOARD OF WATER COMMISSIONERS  
416 North State Street  
Jackson, Mississippi 39201

WATER WELL DRILLERS LOG

9/20/78 19 Coastal Drilling Stone  
date well completed firm name county well located

LANDOWNER: Chas J. Johnson  
P. O. Box 1510, Apt. 414  
Wagon, Miss.  
(mailing address)

description of formations encountered	from	to
Red Clay	1	5
Grey Sand	5	25
Red Clay	25	60
Grey Sand	60	75
Glauk. Coar. Sand	75	104

WELL LOCATION:  
sec. 13 T. 2 S. R. 12 E. W.  
Wagon of  
(distance) (direction) (nearest town)

WELL PURPOSE:  
(home, irrigation, municipal, industrial)  
Municipal

- WELL COMPLETION DATA:
- (1) diameter (inches) 4 1/2
  - (2) total depth (feet) 104 1/2
  - (3) static water level (feet) 100 below top of ground.
  - (4) casing PVC, 99' (material) (depth)  
(size) if telescope see back.
  - (5) screen 15', 99' (length) (depth to top)  
4 1/2, PVC (size) (material)
  - (6) pump 3 Sub (HP) 45 (yield gpm)  
3 1/2 (type power)
  - (7) electric log no (yes or no)

(organization running log)

Miss. Board of Water Comm.

(8) how well bottom plugged  
2" hard wood valve


DRILLERS REMARKS:

APR 29 1979

RECEIVED

If well telescopes please sketch and show depths.

GROUND LEVEL

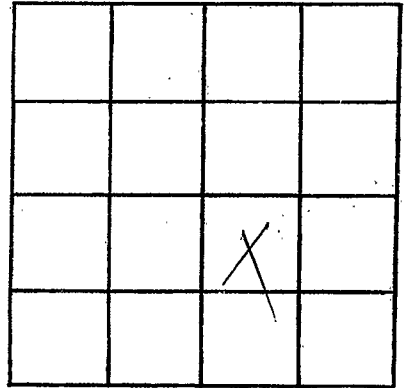

SECTION \_\_\_\_\_

Please indicate well location X.

ADDITIONAL INFORMATION

If more than one screen, show locations of each on sketch.