

STONE
B 2016
09-20-78

MISSISSIPPI
BOARD OF WATER COMMISSIONERS
416 North State Street
Jackson, Mississippi 39201

WATER WELL DRILLERS LOG

7/20/78 19 Coastal Drilling - Stone
date well completed firm name county well located
Bilboe Miss

LANDOWNER: Sam Deltor description of formations encountered from to
P.O. Box 1510 Apt 101 Red Clay 1 5
Wiggins Miss Sugar Sand 5 20
(mailing address) Red Clay 20 45
Fire Sand 45 65
Wash Sand 65 86

WELL LOCATION:
sec. B T 2 N R 2 E
S W
Wiggins miles of (distance) (direction) (nearest town)

WELL PURPOSE: Industrial
(home, irrigation, municipal, industrial)

WELL COMPLETION DATA:
(1) diameter (inches) 4 1/2
(2) total depth (feet) 86'
(3) static water level (feet) 45 below above top of ground.
(4) casing PVC, 66', (material) (depth)
(size) if telescope see back.
(5) screen 20', 66' (length) (depth to top)
4 1/2, PVC (size) (material)
(6) pump 2 HP, 45 (HP) (yield gpm)
4 1/2 (type power)
(7) electric log no (yes or no)

(organization running log)


(8) how well bottom plugged
2" sand wash

DRILLERS REMARKS:

Miss. Board of Water Comm.
APR 23 1979
RECEIVED

If well telescopes please sketch and show depths.

GROUND LEVEL

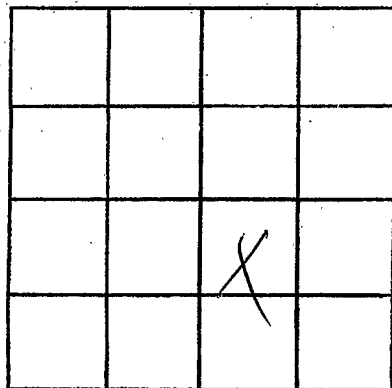

SECTION _____

Please indicate well location X.

ADDITIONAL INFORMATION

If more than one screen,
show locations of each on sketch.