

Store  
B207  
3/30/79  
3-30

MISSISSIPPI  
BOARD OF WATER COMMISSIONERS  
416 North State Street  
Jackson, Mississippi 39201

WATER WELL DRILLERS LOG

date well completed

firm name

county well located

1979 Cornell Andersen

Stone

LANDOWNER:

Frog Cobb

(mailing address)

WELL LOCATION:

sec. 35 T 2 N R 12 E  
1 miles SW of Wright  
(distance) (direction) (nearest town)

WELL PURPOSE: DOMESTIC  
(home, irrigation, municipal, industrial)

WELL COMPLETION DATA:

- (1) diameter (inches) 2"
- (2) total depth (feet) 64'
- (3) static water level (feet) 523' below top of ground.
- (4) casing Plastic 5-9'  
(material) (depth)
- (size) if telescope see back.
- (5) screen 5' 5-9'  
(length) (depth to top)
- 2" Plastic  
(size) (material)
- (6) pump 1 9  
(HP) (yield gpm)
- Elect  
(type power)
- (7) electric log no  
(yes or no)

(organization running log)

(8) how well bottom plugged Capped

description of formations encountered

from to

<u>Top Soil</u>	<u>0</u>	<u>2</u>
<u>Red Clay</u>	<u>2</u>	<u>18</u>
<u>Fine Sand</u>	<u>18</u>	<u>24</u>
<u>Clay</u>	<u>24</u>	<u>45</u>
<u>Coarse Sand</u>	<u>45</u>	<u>64</u>

DRILLERS REMARKS:


Miss. Board of Water Comm.

APR 2 - 1979

RECEIVED

If well telescopes please sketch and show depths.

GROUND LEVEL

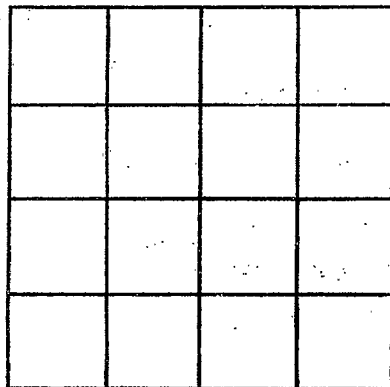

SECTION \_\_\_\_\_

Please indicate well location X.

ADDITIONAL INFORMATION

If more than one screen, show locations of each on sketch.