

Stone
B2018
10-3-79
10-3

MISSISSIPPI
 BOARD OF WATER COMMISSIONERS
 416 North State Street
 Jackson, Mississippi 39201

WATER WELL DRILLERS LOG

date well completed

firm name

county well located

1979 Game Wonders Stone

LANDOWNER:
Morris Fairley
 (mailing address)

WELL LOCATION:
 sec. 11 T. 2 S. R. 12 E.
0 miles 0 of Bond
 (distance) (direction) (nearest town)

WELL PURPOSE: HOME
 (home, irrigation, municipal, industrial)

WELL COMPLETION DATA:

(1) diameter (inches) 2"

(2) total depth (feet) 175'

(3) static water level (feet) 62 below
 top of ground.

(4) casing Plastic, 170'
 (material) (depth)

_____ if telescope see back.
 (size)

(5) screen 5', 170'
 (length) (depth to top)

2", Plastic
 (size) (material)

(6) pump 1 8
 (HP) (yield gpm)

Elect
 (type power)

(7) electric log NO
 (yes or no)

_____ (organization running log)

(8) how well bottom plugged?
Capped

description of formations encountered	from	to
<u>Top Soil</u>	<u>0</u>	<u>2</u>
<u>Red Clay</u>	<u>2</u>	<u>28</u>
<u>Fine Sand</u>	<u>28</u>	<u>85</u>
<u>Clay</u>	<u>85</u>	<u>100</u>
<u>Fine Sand</u>	<u>100</u>	<u>168</u>
<u>Coarse Sand</u>	<u>168</u>	<u>175</u>

DEPT. OF NATURAL RESOURCES
 BUREAU OF LAND & WATER RESOURCES


NOV 20 1979

RECEIVED

DRILLERS REMARKS:

If well telescopes please sketch and show depths.

GROUND LEVEL

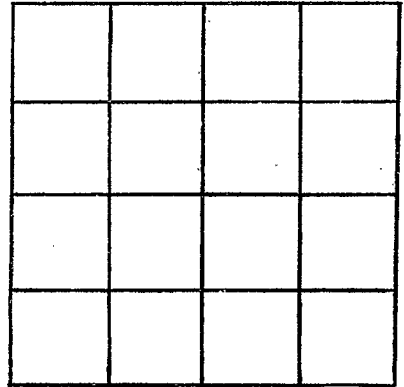

SECTION _____

Please indicate well location X.

ADDITIONAL INFORMATION

If more than one screen,
show locations of each on sketch.