

Stone  
B 20A  
8-13-79

MISSISSIPPI  
BOARD OF WATER COMMISSIONERS  
416 North State Street  
Jackson, Mississippi 39201

WATER WELL DRILLERS LOG

8-13 1979 Carroll Anderson Stone  
date well completed firm name county well located

LANDOWNER:	description of formations encountered	from	to
<u>Noel Hatten</u>	<u>Top Soil</u>	<u>0</u>	<u>2</u>
(mailing address)	<u>Course Sand</u>	<u>2</u>	<u>18</u>
WELL LOCATION:	<u>Blue Clay</u>	<u>18</u>	<u>190</u>
sec. <u>18</u> T <u>2</u> N R <u>12</u> E S W	<u>Course Sand</u>	<u>190</u>	<u>210</u>
<u>7</u> miles <u>W</u> of <u>Wiggins</u> (distance) (direction) (nearest town)			
WELL PURPOSE: <u>HOME</u> (home, irrigation, municipal, industrial)			
WELL COMPLETION DATA:			
(1) diameter (inches) <u>3"</u>			
(2) total depth (feet) <u>210'</u>			
(3) static water level (feet) <u>0</u> below top of ground.			
(4) casing <u>Plastic</u> , <u>200'</u> (material) (depth)			
(size) If telescope see back.			
(5) screen <u>10</u> , <u>200'</u> (length) (depth to top)			
<u>2"</u> , <u>Plastic</u> (size) (material)			
(6) pump <u>1/2</u> , <u>10</u> (HP) (yield gpm)			
<u>Elect</u> (type power)			
(7) electric log <u>no</u> (yes or no)			
(organization running log)			
(8) how well bottom plugged <u>Clayed</u>			

Miss. Board of Water Comm.


SEP 11 1979

DRILLERS REMARKS:

RECEIVED

If well telescopes please sketch and show depths.

GROUND LEVEL

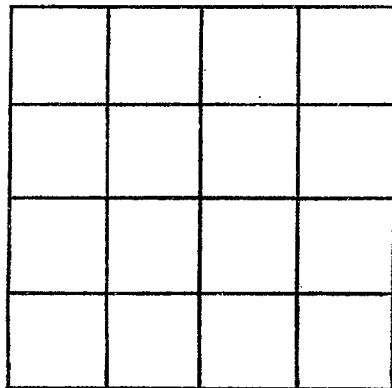

SECTION \_\_\_\_\_

Please indicate well location X.

ADDITIONAL INFORMATION

If more than one screen,  
show locations of each on sketch.