

Stone  
B 2000  
6/21/80

MISSISSIPPI  
BOARD OF WATER COMMISSIONERS  
416 North State Street  
Jackson, Mississippi 39201

WATER WELL DRILLERS LOG

6-21-80 date well completed  
Morse Water Service firm name  
Stone county well located

LANDOWNER: R. R. Moore  
Wiggins Miss 39577  
RT 8 BOX 4567 (mailing address)

description of formations encountered	from to	
Surface clay soil	0	40'
Sand shell	45'	68'
Water sandstone	70'	83'

WELL LOCATION:  
sec. 1 T. 21 N. R. 12 E  
1 miles (distance) miles (direction) of 13 and (nearest town)

WELL PURPOSE: House  
(home, irrigation, municipal, industrial)

WELL COMPLETION DATA: 6-21-80

- (1) diameter (inches) 2"
- (2) total depth (feet) 83'
- (3) static water level (feet) 20' below top of ground
- (4) casing 2" Plastic 78' & 5' Paint  
(material) (depth)
- (size) if telescope see back.
- (5) screen 5" 78'  
(length) (depth to top)
- 2"  
(size) (material)
- (6) pump 3/4 HP 100  
(HP) (yield gpm)
- (type power)
- (7) electric log no  
(yes or no)
- (organization running log)
- (8) how well bottom plugged

DEPT. OF NATURAL RESOURCES  
BUREAU OF LAND & WATER RESOURCES


JUL 21 1980

RECEIVED

DRILLERS REMARKS: Rig for sale  
Plenty water  
- I saw the gas to the top  
Some an they cut off the water well than

If well telescopes please sketch and show depths.

GROUND LEVEL

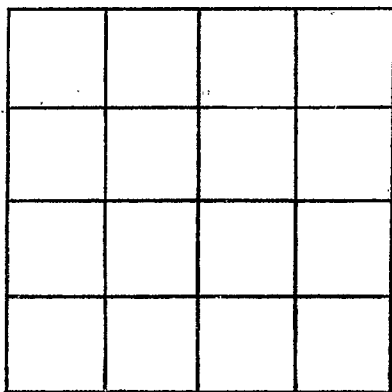

SECTION \_\_\_\_\_

Please indicate well location X.

ADDITIONAL INFORMATION

If more than one screen, show locations of each on sketch.