

MISSISSIPPI DEPARTMENT OF NATURAL RESOURCES

Bureau of Land and Water Resources

Southport Mall

P.O. Box 10631

Jackson, Mississippi 39209

WATER WELL DRILLERS LOG

Stone
B
2021

mar 30 19 81 J B well co Stone
 date well completed firm name county well located

LANDOWNER: <u>DAVID FARMER</u>	description of formations encountered	from	to
<u>Box 304</u> <u>Wiggins MS</u> (mailing address)			
WELL LOCATION: <u>Box 304</u>	<u>NO Sand</u>	<u>0</u>	<u>10</u>
sec <u>24</u> T <u>2</u> N R <u>12</u> E <u>W</u>	<u>SAND</u>	<u>10</u>	<u>20</u>
<u>3</u> miles <u>N</u> of <u>Wiggins</u>	<u>11</u>	<u>20</u>	<u>30</u>
(distance) (direction) (nearest town)	<u>11</u>	<u>30</u>	<u>40</u>
WELL PURPOSE: (home, irrigation, municipal, industrial)	<u>11</u>	<u>40</u>	<u>50</u>
WELL COMPLETION DATA:	<u>11</u>	<u>50</u>	<u>60</u>
(1) diameter (inches) <u>2</u>	<u>11</u>	<u>60</u>	<u>70</u>
(2) total depth (feet) <u>80</u>	<u>11</u>	<u>70</u>	<u>80</u>
(3) static water level (feet) <u>38</u> <u>below</u> above top of ground.			
(4) casing <u>Plastic</u> (material) (depth)			
(size) if telescope see back.			
(5) screen <u>10</u> <u>70</u> (length) (depth to top)			
<u>2</u> <u>PLASTIC</u> (size) (material)			
(6) pump <u>1</u> <u>8-1</u> (HP) (yield gpm)			
<u>ELC</u> (type power)			
(7) electric log (yes or no)			
(organization running log)			
(8) how well bottom plugged			
DRILLERS REMARKS:			


DEPT. OF NATURAL RESOURCES
 BUREAU OF LAND & WATER RESOURCES

MAY 27 1987

RECEIVED

If well telescopes please
sketch and show depths.

GROUND LEVEL

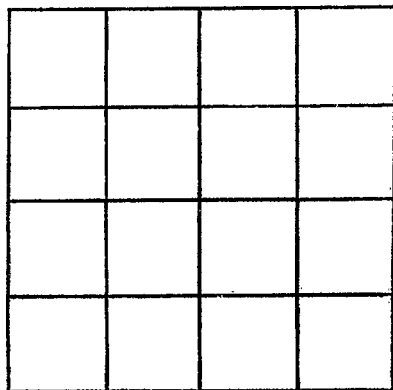

SECTION _____

Please indicate well location X.

ADDITIONAL INFORMATION

If more than one screen,
show locations of each on sketch.