

MISSISSIPPI DEPARTMENT OF NATURAL RESOURCES

Bureau of Land and Water Resources

Southport Mall

P.O. Box 10631

Jackson, Mississippi 39209

WATER WELL DRILLERS LOG

7

STONE
B
5-6-81

5-6-81 date well completed
Coast Water Well Service, Stone firm name
Stone county well located

LANDOWNER: Flasman, G. Inc.
P.O. Box 909
Ocean Springs, Miss.
(mailing address)


WELL LOCATION:
sec. 25 T 2 N R 12 E
S W
2 1/2 miles SW of Wiggins
(distance) (direction) (nearest town)

WELL PURPOSE:
(home, irrigation, municipal, industrial)

WELL COMPLETION DATA:

- (1) diameter (inches) 2"
- (2) total depth (feet) 110'
- (3) static water level (feet) 43' below above top of ground.
- (4) casing PVC, 100'
(material) (depth)
2" if telescope see back.
(size)
- (5) screen 10', 100'
(length) (depth to top)
2" PVC
(size) (material)
- (6) pump 1/2 HP, 8-
(HP) (yield gpm)
Elec.
(type power)
- (7) electric log No.
(yes or no)
- (organization running log)
- (8) how well bottom plugged
Back wash Valve


description of formations encountered	from	to
<u>Top soil</u>	<u>0'</u>	<u>5'</u>
<u>Red Clay</u>	<u>5'</u>	<u>27'</u>
<u>Red Med. sand</u>	<u>27'</u>	<u>55'</u>
<u>Red Clay</u>	<u>55'</u>	<u>60'</u>
<u>Red Coars. sand</u> <u>+ gravel</u>	<u>60'</u>	<u>110'</u>

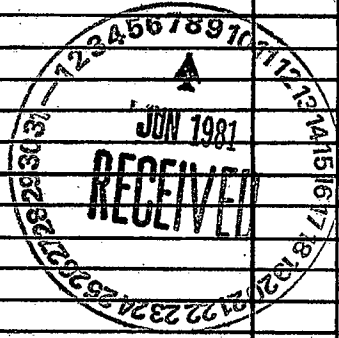

DRILLERS REMARKS:

If well telescopes please sketch and show depths.

GROUND LEVEL

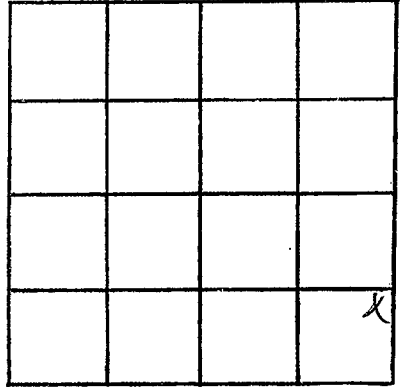

SECTION 25

Please indicate well location X.

ADDITIONAL INFORMATION

If more than one screen,
show locations of each on sketch.