

Stone
 B2023
 6-1-81

MISSISSIPPI
 BOARD OF WATER COMMISSIONERS
 416 North State Street
 Jackson, Mississippi 39201

WATER WELL DRILLERS LOG

BRADEN PUMP AND WELL SERVICE, INC. Stone

6-1 1981 ROUTE 1, BOX 489 firm name county well located
 SAUCIER, MS 39574

LANDOWNER:
 O.C. ROGERS
 Rt. 2 Box 137-A
 Wiggins, MS 39577
 (mailing address)

description of formations encountered	from	to
CLAY	0	20
SAND	20	47
CLAY	47	90
SAND	90	120

WELL LOCATION:
 sec. 17 T 2 N R 12 E
 3 1/2 miles NW of Wiggins
 (distance) (direction) (nearest town)

WELL PURPOSE: HOME
 (home, irrigation, municipal, industrial)

- WELL COMPLETION DATA:
- (1) diameter (inches) 2"
 - (2) total depth (feet) 120
 - (3) static water level (feet) 65 below top of ground.
 - (4) casing PVC, total!
 (material) (depth)
 2" If telescope see back.
 (size)
 - (5) screen 10 90
 (length) (depth to top)
 2" PVC underbar
 (size) (material)
 - (6) pump 1 10
 (HP) (yield gpm)
 230
 (type power)
 - (7) electric log NO
 (yes or no)
 (organization running log)
 - (8) how well bottom plugged
 2" sand shark

DEPT. OF NATURAL RESOURCES
 BUREAU OF LAND & WATER RESOURCES


JUL 21 1981

RECEIVED

DRILLERS REMARKS:
 10' tail pipe

If well telescopes please sketch and show depths.

GROUND LEVEL

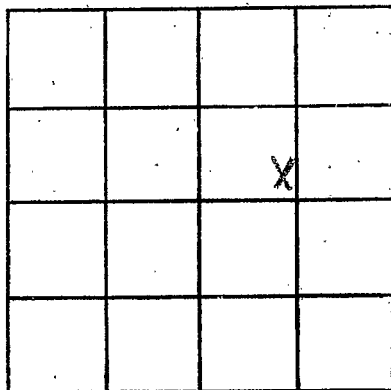

SECTION 17

Please indicate well location X.

ADDITIONAL INFORMATION

If more than one screen, show locations of each on sketch.