

MISSISSIPPI DEPARTMENT OF NATURAL RESOURCES

Bureau of Land and Water Resources

Southport Mall

P.O. Box 10631

Jackson, Mississippi 39209

WATER WELL DRILLERS LOG

Stone
B 2004
8-14-81

8-14

1981

Parnell Anderson Stone

date well completed

firm name

county well located

LANDOWNER: James H Walker
Rt 1
Wiggins, Ms 39577
 (mailing address)

Description of formations encountered

from

to

Top soil	0	2
Clay	2	18
Sand	18	36
Sands Clay	36	64
Coarse sand	64	80
Sand + gravel	80	89

WELL LOCATION:
 sec 21 T 2 N R. 12E
1 miles W of Wiggins
 (distance) (direction) (nearest town)

WELL PURPOSE:
 (home, irrigation, municipal, industrial)


WELL COMPLETION DATA:

- (1) diameter (inches) 2"
- (2) total depth (feet) 89'
- (3) static water level (feet) 40' below above top of ground.
- (4) casing PVC, 84' (material) (depth)
 (size) if telescope see back.
- (5) screen 5', 84' (length) (depth to top)
2" (size) PVC (material)
- (6) pump 1 (HP) 12 (yield gpm)
Electric (type power)
- (7) electric log NO (yes or no)

(organization running log)


- (8) how well bottom plugged Capped

DRILLERS REMARKS:

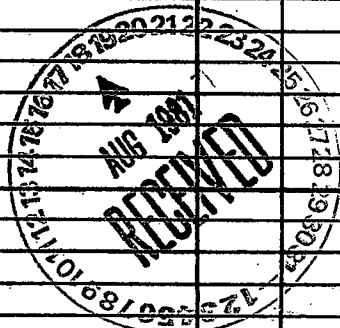

If well telescopes please sketch and show depths.

GROUND LEVEL

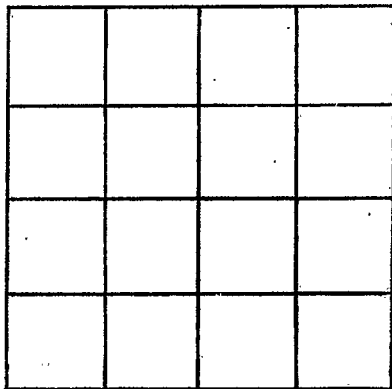

SECTION _____

Please indicate well location X.

ADDITIONAL INFORMATION

If more than one screen,
show locations of each on sketch.