

MISSISSIPPI DEPARTMENT OF NATURAL RESOURCES

Bureau of Land and Water Resources

Southport Mall

P.O. Box 10631

Jackson, Mississippi 39209

WATER WELL DRILLERS LOG

Stone
B
2025

4-20-82 Frank Price Stone  
 date well completed firm name county well located

LANDOWNER:	description of formations encountered	from	to
First Baptist Church	Top Soil	0	2
of Wiggins (mailing address)	Course Sand	2	30

WELL LOCATION:  
 sec 28 T 2 R 12 S  
 2 1/2 miles W of Hwy 49  
 (distance) (direction) (nearest town)

WELL PURPOSE: MUNICIPAL  
 (home, irrigation, municipal, industrial)

- WELL COMPLETION DATA:
- (1) diameter (inches) 2"
  - (2) total depth (feet) 30'
  - (3) static water level (feet) 15' below top of ground.
  - (4) casing Plastic, 25' (material) (depth)
  - \_\_\_\_\_ if telescope see back. (size)
  - (5) screen 5' , 25' (length) (depth to top)  
 2" , Plastic (size) (material)
  - (6) pump \_\_\_\_\_ (HP) \_\_\_\_\_ (yield gpm)  
 HAND PUMP (type power)
  - (7) electric log no (yes or no)
  - \_\_\_\_\_ (organization running log)
  - (8) how well bottom plugged capped

DRILLERS REMARKS:


DEPT. OF NATURAL RESOURCES  
 BUREAU OF LAND & WATER RESOURCES  
 JACSON

MAY 10 1982

RECEIVED

If well telescopes please sketch and show depths.

GROUND LEVEL

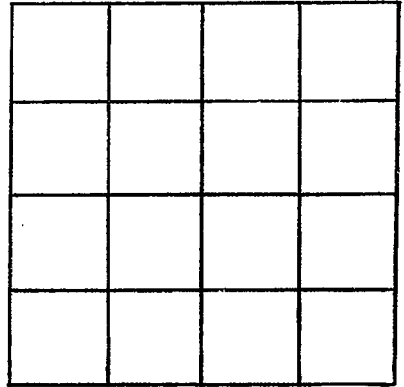

SECTION \_\_\_\_\_

Please indicate well location X.

ADDITIONAL INFORMATION

If more than one screen, show locations of each on sketch.