

MISSISSIPPI DEPARTMENT OF NATURAL RESOURCES

Bureau of Land and Water Resources

Southport Mall

P.O. Box 10631

Jackson, Mississippi 39209

WATER WELL DRILLERS LOG

Stone
Boone

5-13 1982 Frank Price Stone
date well completed firm name county well located


LANDOWNER:	description of formations encountered	from	to
<u>Batson Brothers</u>	<u>Top Soil</u>	<u>0</u>	<u>2</u>
(mailing address)	<u>Clay</u>	<u>2</u>	<u>135</u>
WELL LOCATION:	<u>Hard Sand</u>	<u>135</u>	<u>142</u>
sec <u>33</u> T <u>2</u> N <u>2</u> R <u>12</u> E	<u>Clay</u>	<u>142</u>	<u>158</u>
<u>1</u> miles <u>West</u> of <u>Red Creek</u>	<u>Course Sand</u>	<u>158</u>	<u>173</u>
(distance) (direction) (nearest town)			
WELL PURPOSE: <u>HOME</u> (home, irrigation, municipal, industrial)			
WELL COMPLETION DATA:			
(1) diameter (inches) <u>2"</u>			
(2) total depth (feet) <u>173'</u>			
(3) static water level (feet) <u>88</u> below above top of ground.			
(4) casing <u>Plastic</u> , <u>168'</u> (material) (depth)			
_____ If telescope see back. (size)			
(5) screen <u>5'</u> , <u>168'</u> (length) (depth to top)			
<u>2"</u> , <u>Plastic</u> (size) (material)			
(6) pump <u>1</u> <u>7</u> (HP) (yield gpm)			
<u>Elect</u> (type power)			
(7) electric log <u>no</u> (yes or no)			
_____ (organization running log)			
(8) how well bottom plugged <u>Back wash checked</u>			
DRILLERS REMARKS:			

DEPT. OF NATURAL RESOURCES
BUREAU OF LAND & WATER RESOURCES

JUN 15 1982
RECEIVED

If well telescopes please sketch and show depths.

GROUND LEVEL

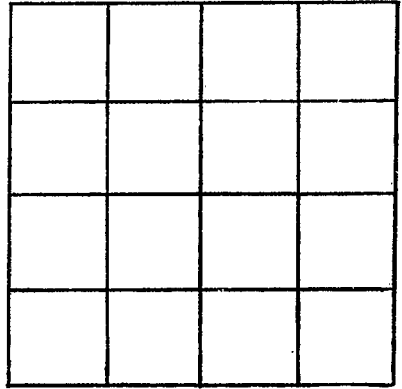

SECTION _____

Please indicate well location X.

ADDITIONAL INFORMATION

If more than one screen,
show locations of each on sketch.