

MISSISSIPPI DEPARTMENT OF NATURAL RESOURCES

Bureau of Land and Water Resources

Southport Mall

P.O. Box 10631

Jackson, Mississippi 39209

WATER WELL DRILLERS LOG

Stone
Booz

2-24 1984
date well completed

Frank Price
firm name

Stone
county well located

LANDOWNER:
Don Hester

(mailing address)

description of formations encountered	from	to
<u>Top Soil</u>	<u>0</u>	<u>3</u>
<u>Sandy Clay</u>	<u>3</u>	<u>32</u>
<u>Coarse Sand</u>	<u>32</u>	<u>104</u>

WELL LOCATION:
sec. 25 T. 2 R. 12 E
Wiggins City Limits
miles of (distance) (direction) (nearest town)

WELL PURPOSE: HOME
(home, irrigation, municipal, industrial)

WELL COMPLETION DATA:

(1) diameter (inches) 2"

(2) total depth (feet) 104'

(3) static water level (feet) 40' below
top of ground. above

(4) casing PVC, 99'
(material) (depth)

_____ If telescope see back.
(size)

(5) screen 5", 99'
(length) (depth to top)

2", PVC
(size) (material)

(6) pump 1 12
(HP) (yield gpm)

Elect
(type power)

(7) electric log no
(yes or no)

_____ (organization running log)

(8) how well bottom plugged B.W.V.

DRILLERS REMARKS:


DEPT. OF NATURAL RESOURCES
BUREAU OF LAND & WATER RESOURCES

MAR 12 1984

RECEIVED

If well telescopes please sketch and show depths.

GROUND LEVEL

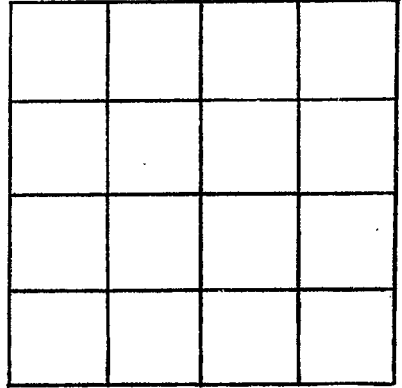

SECTION _____

Please indicate well location X.

ADDITIONAL INFORMATION

If more than one screen,
show locations of each on sketch.