

MISSISSIPPI DEPARTMENT OF NATURAL RESOURCES

Bureau of Land and Water Resources

Southport Mall

P.O. Box 10631

Jackson, Mississippi 39209

WATER WELL DRILLERS LOG

STONE
B 300A

7-3 1984
date well completed

Frank Piel
firm name

Stone
county well located

LANDOWNER:
How Meadows
(mailing address)

WELL LOCATION:
sec 23 T 2 S R 12 W
1/2 miles W of W. Laghna
(distance) (direction) (nearest town)

WELL PURPOSE: HOME
(home, irrigation, municipal, industrial)

WELL COMPLETION DATA:

(1) diameter (inches) 2"
(2) total depth (feet) 95'
(3) static water level (feet) 35' below top of ground.
(4) casing PVC, 90' (material), (depth)
if telescope see back.
(5) screen 5' 90' (length), (depth to top)
2" PVC (size), (material)
(6) pump 1 10 (HP), (yield gpm)
Elect (type power)
(7) electric log NO (yes or no)
(organization running log)
(8) how well bottom plugged CBW

description of formations encountered	from	to
Top Soil	0	2
Clay	2	10
Fine Sand	15	85
Coarse Sand	85	95

DRILLERS REMARKS:


MISSISSIPPI DEPARTMENT OF NATURAL RESOURCES
BUREAU OF LAND & WATER RESOURCES

SEP - 7 1984

RECEIVED

If well telescopes please sketch and show depths.

GROUND LEVEL

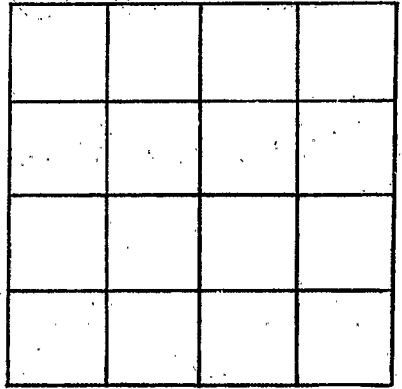

SECTION _____

Please indicate well location X.

ADDITIONAL INFORMATION

If more than one screen,
show locations of each on sketch.