

MISSISSIPPI DEPARTMENT OF NATURAL RESOURCES

Bureau of Land and Water Resources

Southport Mall

P.O. Box 10631

Jackson, Mississippi 39209

WATER WELL DRILLERS LOG

B 2032  
 STONE  
 3-5-85

3-5-85 date well completed      1985 Frank Price firm name      Stone county well located

LANDOWNER:  
 R. L. Stewart  
 (mailing address)

description of formations encountered	from	to
Top Soil	0	3
Red Clay	3	18
White Clay	18	68
Sand	68	115

WELL LOCATION:  
 sec 25 T 2 N R 12 E  
 City Limits of W. Yagala  
 miles (distance)      of (direction)      (nearest town)

WELL PURPOSE: HOME  
 (home, irrigation, municipal, industrial)

WELL COMPLETION DATA:

(1) diameter (inches) 2"

(2) total depth (feet) 115'

(3) static water level (feet) 50' below top of ground.

(4) casing PVC, 110' (material) (depth)  
 (size) If telescope see back.

(5) screen 5' 110' (length) (depth to top)  
 2" PVC (size) (material)

(6) pump 1 (HP) 9 (yield gpm)  
 Elect (type power)

(7) electric log no (yes or no)  
 (organization running log)

(8) how well bottom plugged BWV


RECEIVED  
 APR 17 1985

DRILLERS REMARKS:

Department of Natural Resources  
 Bureau of Land & Water Resources

If well telescopes please sketch and show depths.

GROUND LEVEL

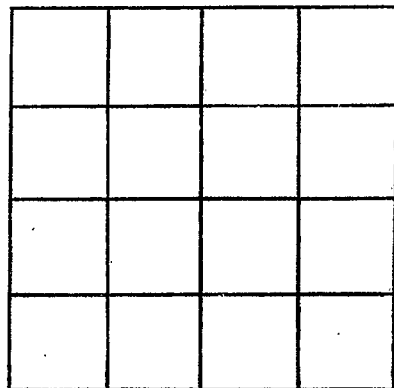

SECTION \_\_\_\_\_

Please indicate well location X.

ADDITIONAL INFORMATION

If more than one screen,  
show locations of each on sketch.