

MISSISSIPPI DEPARTMENT OF NATURAL RESOURCES

Bureau of Land and Water Resources

Southport Mall

P.O. Box 10631

Jackson, Mississippi 39209

WATER WELL DRILLERS LOG

Stone
B 2034

1-29 date well completed 87K Frank Price firm name Stone county well located

LANDOWNER: Soney Wabsmith
 (mailing address)

WELL LOCATION:
 sec 23 T 2 R 12 W
Wiggins
 (distance) miles (direction) of (nearest town)

WELL PURPOSE: HOME
 (home, irrigation, municipal, industrial)

WELL COMPLETION DATA:

(1) diameter (inches) 2"

(2) total depth (feet) 180'

(3) static water level (feet) 60 below above top of ground.

(4) casing PVC, 115' (material) (depth)

(size) If telescope see back.

(5) screen 5', 115' (length) (depth to top)

2", PVC (size) (material)

(6) pump 1 (HP) 8 (yield gpm)

Elect (type power)

(7) electric log no (yes or no)

(organization running log)

(8) how well bottom plugged BWV

| description of formations encountered | from | to |
|---------------------------------------|------------|------------|
| <u>Top Soil</u> | <u>0</u> | <u>2</u> |
| <u>Sandy Clay</u> | <u>2</u> | <u>22</u> |
| <u>Clay</u> | <u>22</u> | <u>65</u> |
| <u>Fine Sand</u> | <u>65</u> | <u>80</u> |
| <u>Clay</u> | <u>80</u> | <u>105</u> |
| <u>Course Sand</u> | <u>105</u> | <u>120</u> |

RECEIVED


OCT 15 1987

Department of Natural Resources
 Bureau of Land & Water Resources

DRILLERS REMARKS:

If well telescopes please sketch and show depths.

GROUND LEVEL

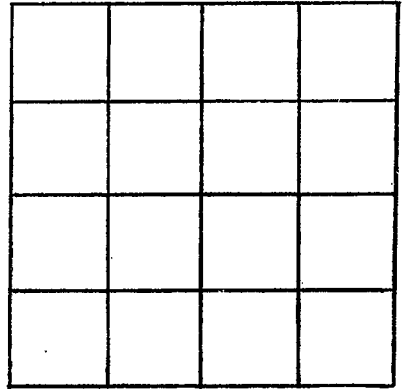

SECTION _____

Please indicate well location X.

ADDITIONAL INFORMATION

If more than one screen, show locations of each on sketch.