

MISSISSIPPI DEPARTMENT OF NATURAL RESOURCES

Bureau of Land and Water Resources

P.O. Box 10631

Jackson, Mississippi 39209

WATER WELL DRILLERS LOG

COUNTY WELL LOCATED Stone	
WELL NUMBER B0035	CODED
DATE WELL COMPLETED 4/13/91	

PERMIT NUMBER
NAME OF DRILLING FIRM Moore Water Well Serv.

NAME & MAILING ADDRESS OF LANDOWNER R. W. Ferguson Sr. Wiggins MS, 39577		
WELL LOCATION: SEC	TOWNSHIP	RANGE
28	T2	N R12 E
DISTANCE _____ Miles	DIRECTION _____	NEAREST TOWN _____
OTHER LANDMARK		
WELL PURPOSE: <u>Home</u> , Irrigation, Municipal, Industrial, Fish Pond, etc. Home		

PUMP DATA		
PUMP TYPE (Circle One): Submersible, Turbine, Jet Flowing Well, Other (Describe) _____		
POWER TYPE (Circle One): Electric , Tractor, Diesel, Gasoline, Butane, Other (Describe) _____ H/P _____		
Pump Capacity (GPM) 6 gpm	No. of Stages 2	Setting Depth _____ FT.
PUMP TEST		
Well yielded _____ GPM with a drawdown of _____ ft. after _____ hours of pumping		

WELL DATA		
Well Depth 32ft.	Casing Diameter (In.) 2"	Casing Length (Ft.) 22ft.
Type of Casing PVC	Hole Depth 32ft.	Depth to Static Water Level 16ft.
TYPE OF COMPLETION: (Circle One or More): Natural Development , Underreamed, Telescoped, Open Hole, Other		
Top of Lap Pipe or Reduction in Casing		
FEET IF TELESCOPED OR MORE THAN ONE SCREEN: USE BACK PAGE		

LOG DATA	
TYPE OF LOG RUN (Circle One): No Log Run, Electric, Gamma Ray, Density, Sonic, Neutron, Other (Describe) _____	
Name of Organization Running Log	

SCREEN DATA		
Diameter - Inches 2"	Length - Feet 10'	Slot Size - Inches .010
Screen Type PVC		Depth to Bottom - Feet 32ft.

GEOLOGIC DATA (Office Use Only)			
Surface Elev.	Geologic Unit	Unit Thickness	Depth to Top
Subs. SWL	Date	Analysis	Aquifer Test

Driller's Remarks

RECEIVED

APR 22 1991


Dept. of Environmental Quality
Bureau of Land & Water Resources

DESCRIPTION OF FORMATIONS ENCOUNTERED	FROM	TO	FORMATIONS (Continued)	
			FROM	TO
top soil	1'	9'		
Soapstone (white)	9'	14'		
rust color soapstone	14'	16'		
gray soapstone	16'	19'		
coarse sand & gravel	19'	32'		
white soapstone	32'			

IF MORE SPACE IS NEEDED, USE BACK

If well telescopes please
sketch and show depths.

GROUND LEVEL

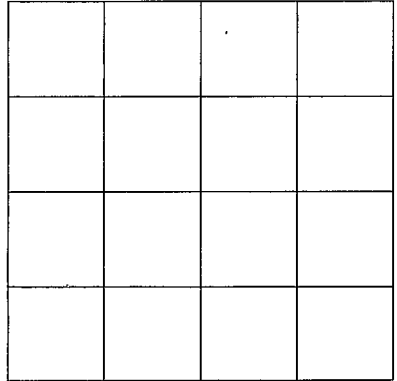

SECTION _____

Please indicate well location X.

ADDITIONAL INFORMATION

If more than one screen,
show location of each on sketch.