

STONE MISSISSIPPI BOARD OF WATER COMMISSIONERS

C 11

4-24-64

WATER WELL DRILLERS LOG

CODED

Date: April 24, 1964, Driller: JAY LOTT County: STONE  
of 168 2451 (Name)

(1) Owner of Land: N. B. COLVIN  
(Name)  
Wiggins, Mississippi Rt 1  
(Address) 35 24

(2) Location: 1/4, 1/4, Sec. T. R.  
3 miles EAST, of Wiggins  
(distance) (direction) (Nearest Town)

(3) Topography:  (Hilly)  (Flat)  (Level)

(4) Purpose of Well:  Domestic Irrigation  
 Municipal, Industrial, Other

Description & Color of Materials Sand, Clay, Red Clay, Shell, etc.	Thick- ness Feet	Depth Feet
0-12- R.C		
12-40 R.S		
40-60 W.S		
60-70- R.C		
70-90. W.R		
90-110. W-S.		
45 feet to water		
10 foot screen		

Information upon completion of well:

(1) Diameter 2 inches.

(2) Total Depth 110 feet.

(3) Water Level 45 feet below top of ground.

(4) Cased to 2 inch, Size 2 inch


(5) Screen: Size BAOWEE, Length 10 FT

(6) Were any formations sealed against pollution?  
 \_\_\_\_\_ yes, \_\_\_\_\_ no.

If YES depth of formation \_\_\_\_\_

Why \_\_\_\_\_

Drillers Remarks: \_\_\_\_\_

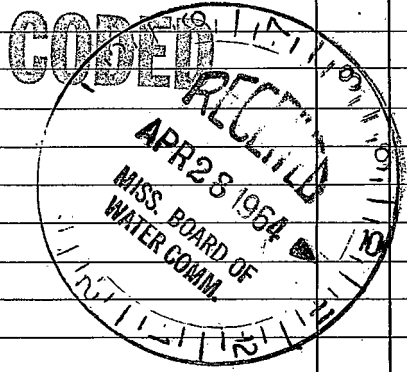

(Use Back Side)

Well No.

