

STONE  
C 16  
5-68

MISSISSIPPI  
BOARD OF WATER COMMISSIONERS  
416 North State Street  
Jackson, Mississippi 39201

CODED

WATER WELL DRILLERS LOG

5-22 19 68 L. W. Smith Stone  
date well completed firm name county well located

LANDOWNER: J. V. Hatten

description of formations encountered

from to

Top Soil	0	2
Clay	2	12
Sand	12	60
Clay		

(mailing address)

WELL LOCATION:

sec. 9 T 2 N R 11 E  
S W

(distance) miles (direction) of (nearest town)

WELL PURPOSE:

(home, irrigation, municipal, industrial)

WELL COMPLETION DATA:

- (1) diameter (inches) 2  
 (2) total depth (feet) 60  
 (3) static water level (feet) 20' below top of ground.  
 (4) casing Plastic, 60' (material) (depth)

(size) If telescope see back.

- (5) screen 5' 55' (length) (depth to top)  
 2" 2" (size) (material)

- (6) pump 1/2 8 (HP) (yield gpm)

Electric (type power)

- (7) electric log no (yes or no)

(organization running log)


- (8) how well bottom plugged Backward

DRILLERS REMARKS:

JUN 1968

If well telescopes please sketch and show depths.

GROUND LEVEL

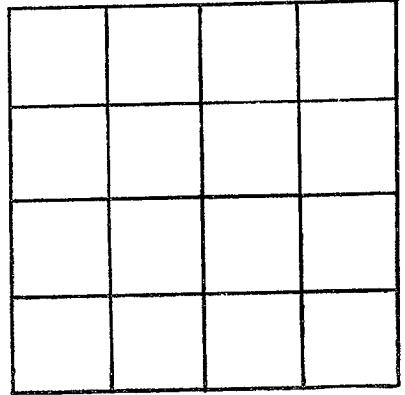

SECTION \_\_\_\_\_

Please indicate well location X.

ADDITIONAL INFORMATION

If more than one screen, show locations of each on sketch.