

STONE
C17
9-14-60

WATER WELL DRILLERS LOG

CODED

Date: 9/14, 1960, Driller: 662

(Name)

County STONE

- (1) Owner of Land: LULA HALL
(Name)
Wiggins, Miss
(Address)
- (2) Location NE 1/4, SW 1/4, Sec 27 T2R11,
3 miles EAST of Wiggins
(distance) (direction) (Nearest Town)
- (3) Topography: X
(Hilly) (Flat) (Level)
- (4) Purpose of Well: DOMESTIC
(Domestic Irrigation
Municipal, Industrial, Other)

Description & Color of Materials
Sand, Clay, Red Clay, Shell, etc.

Thick-
ness
Feet

Depth
Feet

yellow clay
yellow sand

0-20
20-85

CODED



Information upon completion of well:

- (1) Diameter 2 inches.
- (2) Total Depth 85 feet.
- (3) Water Level 40 feet below top of ground.
- (4) Cased to _____, Size _____
- (5) Screen: Size 2", Length 10 ft.
- (6) Were any formations sealed against pollution?
_____ yes, A no.

If YES depth of formation _____

Why _____

Drillers Remarks: _____

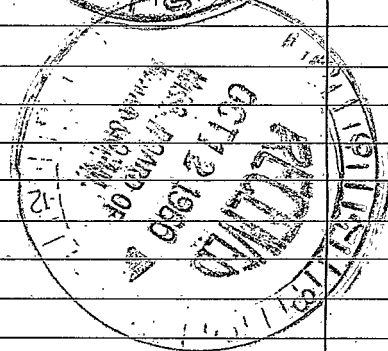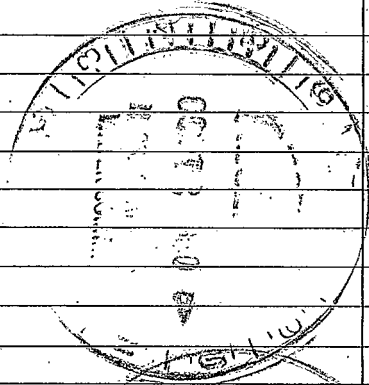

(Use Back Side)

Well No.

