

MISSISSIPPI
BOARD OF WATER COMMISSIONERS
416 North State Street
Jackson, Mississippi 39201

WATER WELL DRILLERS LOG

6-15 19 67 HATTIESBURG Botawne Stone
date well completed firm name county well located

LANDOWNER: OLIVER PEARSON

Route 1 WIGGINS, Miss

(mailing address)

WELL LOCATION:

sec. 8 T. 2 S. R. 11 W.
2 miles NE of WIGGINS
(distance) (direction) (nearest town)

WELL PURPOSE: Home
(home, irrigation, municipal, industrial)


WELL COMPLETION DATA:

- (1) diameter (inches) 2"
- (2) total depth (feet) 137'
- (3) static water level (feet) 52' below above top of ground.
- (4) casing Galv. pipe, 127'
(material) (depth)
2" if telescope see back.
(size)
- (5) screen 10', 127'
(length) (depth to top)
2", BRONZE
(size) (material)
- (6) pump 1, 325
(HP) (yield gpm)
electric
(type power)
- (7) electric log NO
(yes or no)
NO
(organization running log)
- (8) how well bottom plugged BACK WASH VALVE

description of formations encountered

from to

Red clay	0	17
Red sand	18	25
yellow clay	26	33
white clay	34	77
Blue clay	78	84
Gray sand	85	105
white sand	106	137

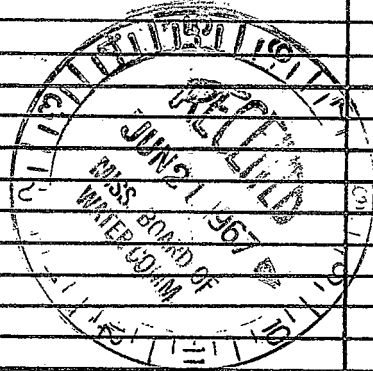

DRILLERS REMARKS:

If well telescopes please sketch and show depths.

GROUND LEVEL

	8		
	X		

SECTION 8

Please indicate well location X.

ADDITIONAL INFORMATION

*Go out Highway 29
toward Janice -
Second house on left.*

If more than one screen,
show locations of each on sketch.