

Stone
C19
8-67

MISSISSIPPI
BOARD OF WATER COMMISSIONERS
416 North State Street
Jackson, Mississippi 39201

WATER WELL DRILLERS LOG

8-18 1967 HATTIESBURG, Miss. Stone
date well completed firm name county well located

LANDOWNER: Mills Bond

Rt. 1 WIGGINS, Miss.

(mailing address)

description of formations encountered

from to

Red sand	0	7
Yellow sand	8	13
Red sand	14	20
White sand	21	29
Yellow sand	30	35
White sand	36	82


WELL LOCATION:

sec. 20 T. 2 S. R. 11 W.
1/4 miles EAST of WIGGINS
(distance) (direction) (nearest town)

WELL PURPOSE: Home
(home, irrigation, municipal, industrial)

WELL COMPLETION DATA:


- diameter (inches) 2"
- total depth (feet) 82'
- static water level (feet) 43' below top of ground.
- casing GALV. pipe 72' (material) (depth)
2" (size) if telescope see back.
- screen 10' 72' (length) (depth to top)
2" BRONZE (size) (material)
- pump 1 MSE 425 (HP) (yield gpm)
electric (type power)
- electric log NO (yes or no)
NO (organization running log)
- how well bottom plugged BACK WASH VALVE

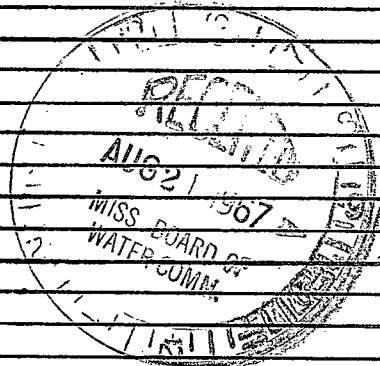

DRILLERS REMARKS:

If well telescopes please sketch and show depths.

GROUND LEVEL

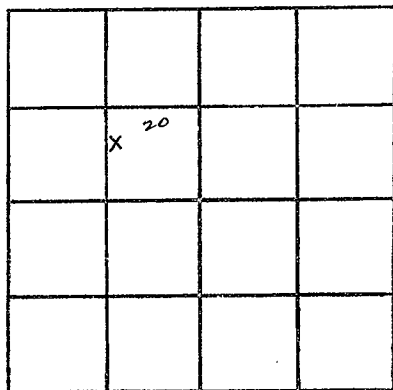

SECTION 20

Please indicate well location X.

ADDITIONAL INFORMATION

If more than one screen,
show locations of each on sketch.