

CODED

MISSISSIPPI  
BOARD OF WATER COMMISSIONERS  
416 North State Street  
Jackson, Mississippi 39201

WATER WELL DRILLERS LOG

Stone  
C22  
1-67

1-31 1967 date well completed  
L W Smith firm name  
Stone county well located

LANDOWNER:

W E Martin  
Wiggins Miss  
(mailing address)

description of formations  
encountered

from to

|          |    |     |
|----------|----|-----|
| Top Soil | 0  | 2   |
| Clay     | 2  | 35  |
| Sand     | 35 | 46  |
| Clay     | 46 | 70  |
| Sand     | 70 | 96  |
| Clay     | 96 | 105 |

WELL LOCATION:

sec. 8 T 2 N R 11 E  
3 miles N-E of Wiggins  
(distance) (direction) (nearest town)

WELL PURPOSE:

(home, irrigation, municipal, industrial)

WELL COMPLETION DATA:

- (1) diameter (inches) 2
- (2) total depth (feet) 95
- (3) static water level (feet) 40 below top of ground.
- (4) casing Plastic, 95 (material) (depth)

if telescope see back.  
(size)

- (5) screen 5' (length) (depth to top)  
2" Plastic (size) (material)

- (6) pump 1 (HP) 7 (yield gpm)

Electric (type power)

- (7) electric log no (yes or no)

(organization running log)


- (8) how well bottom plugged Backwash

DRILLERS REMARKS:



If well telescopes please sketch and show depths.

GROUND LEVEL

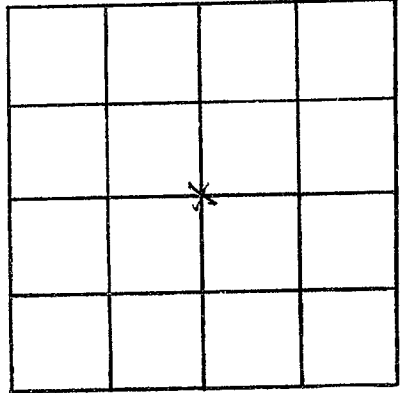

SECTION 8

Please indicate well location X.

ADDITIONAL INFORMATION

If more than one screen,  
show locations of each on sketch.