

CODED

CODED

CODED

MISSISSIPPI  
 BOARD OF WATER COMMISSIONERS  
 416 North State Street  
 Jackson, Mississippi 39201

WATER WELL DRILLERS LOG

Stone
C 24
10-68

19 1968 Arnold Underwood firm name Stone county well located

LANDOWNER: V. E. Brown

Wiggins Miss

(mailing address)

description of formations encountered

from to

<u>Top Soil &amp; Sand</u>	<u>0</u>	<u>5</u>
<u>Clay with sand st</u>	<u>5</u>	<u>60</u>
<u>Fine Sand</u>	<u>60</u>	<u>85</u>
<u>Coarse Sand &amp; Gravel</u>	<u>85</u>	<u>98</u>

WELL LOCATION:

sec 31 T 2 N R 11 W  
2 1/2 miles South of Wiggins  
 (distance) (direction) (nearest town)

WELL PURPOSE: Home  
 (home, irrigation, municipal, industrial)

WELL COMPLETION DATA:

(1) diameter (inches) 2  
 (2) total depth (feet) 98  
 (3) static water level (feet) 58 below above top of ground.

(4) casing Plastic, 92  
 (material) (depth)

(size) if telescope see back.

(5) screen 6, 92  
 (length) (depth to top)

2, Plastic  
 (size) (material)

(6) pump 1, 8  
 (HP) (yield gpm)


Electric  
 (type power)

(7) electric log (yes or no) \_\_\_\_\_

(organization running log)

(8) how well bottom plugged  
Back wash valve

DRILLERS REMARKS:

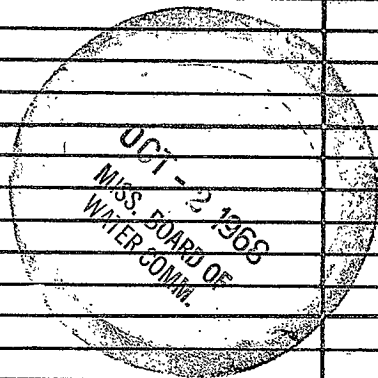

If well telescopes please sketch and show depths.

GROUND LEVEL

X			

SECTION 31

Please indicate well location X.

ADDITIONAL INFORMATION

If more than one screen, show locations of each on sketch.