

MISSISSIPPI  
BOARD OF WATER COMMISSIONERS  
416 North State Street  
Jackson, Mississippi 39201

WATER WELL DRILLERS LOG

*Stone*  
C27  
8-28-68

8-28 1968 date well completed  
L W Smith firm name  
Stone county well located

LANDOWNER:  
*Carl Rouse*  
*Wiggins*  
(mailing address)

description of formations encountered	from	to
	<i>Tap</i>	<i>0</i>
<i>Clay</i>	<i>1</i>	<i>40</i>
<i>Sand</i>	<i>40</i>	<i>68</i>

WELL LOCATION:  
sec. *9* T *2* S R *11* W  
*4* miles *SE* of *Wiggins*  
(distance) (direction) (nearest town)

WELL PURPOSE:  
(home, irrigation, municipal, industrial)

WELL COMPLETION DATA:

(1) diameter (inches) *2"*

(2) total depth (feet) *68'*

(3) static water level (feet) *40'* below top of ground.

(4) casing *Gal.* (material) (depth)

\_\_\_\_\_ If telescope see back.  
(size)

(5) screen *3'* *64'*  
(length) (depth to top)  
*2"*  
(size) (material)

(6) pump \_\_\_\_\_ (HP) \_\_\_\_\_ (yield gpm)  
*Wind Mill*  
(type power)

(7) electric log \_\_\_\_\_  
(yes or no)  
\_\_\_\_\_  
(organization running log)

(8) how well bottom plugged *B.W.*

*COPIED*


FEB - 4 1968

MISS. BD. OF  
WATER COMM.

DRILLERS REMARKS:

If well telescopes please sketch and show depths.

GROUND LEVEL

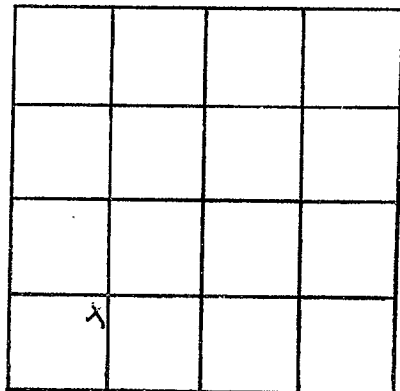

SECTION 9

Please indicate well location X.

ADDITIONAL INFORMATION

If more than one screen,  
show locations of each on sketch.