

Stone
C 30
11-69

MISSISSIPPI
BOARD OF WATER COMMISSIONERS
416 North State Street
Jackson, Mississippi 39201

CODED
CODED


WATER WELL DRILLERS LOG

Nov 1969 date well completed S & R firm name Stone county well located

LANDOWNER: <u>L.B. Henry</u> <u>Drilling Co</u> <u>Alexandria La</u> (mailing address)	description of formations encountered	from	to
WELL LOCATION: sec. <u>31</u> T. <u>2</u> N. R. <u>11</u> E. S. <u>1</u> W. <u>5</u> <u>1</u> miles <u>S</u> of <u>Wiggins</u> (distance) (direction) (nearest town)	<u>Red Clay</u> <u>Fine Sand</u> <u>C.W.B. Sand</u> <u>Soft & pink clay shales</u> <u>Red & pink clay shales</u> <u>Fine Sand</u> <u>C.W.B. Sand</u> <u>Clay</u>	<u>0</u> <u>13</u> <u>70</u> <u>73</u> <u>88</u> <u>100</u> <u>117</u> <u>147</u>	<u>13</u> <u>20</u> <u>73</u> <u>88</u> <u>100</u> <u>117</u> <u>147</u> <u>152</u>
WELL PURPOSE: <u>Supply</u> (home, irrigation, municipal, industrial)	<p><u>This Supply Well is at the Site of the Mine of International Paper Co Wiggins Miss</u></p>		
<p>WELL COMPLETION DATA:</p> <p>(1) diameter (inches) <u>4</u></p> <p>(2) total depth (feet) <u>147</u></p> <p>(3) static water level (feet) _____ below above top of ground.</p> <p>(4) casing <u>Steel</u> <u>126</u> (material) (depth) <u>4"</u> If telescope see back. (size)</p> <p>(5) screen <u>20</u> <u>126</u> (length) (depth to top) <u>20</u> <u>S/S</u> (size) (material)</p> <p>(6) pump <u>air lift</u> (HP) (yield gpm) <u>at 100 ft</u> (type power) <u>50 HP M</u></p> <p>(7) electric log _____ (yes or no) _____ (organization running log)</p> <p>(8) how well bottom plugged <u>Value.</u></p>			
DRILLERS REMARKS:	<p>DEC 23 1969</p> <p>MISS. BD. OF WATER COM.</p>		

If well telescopes please sketch and show depths.

GROUND LEVEL

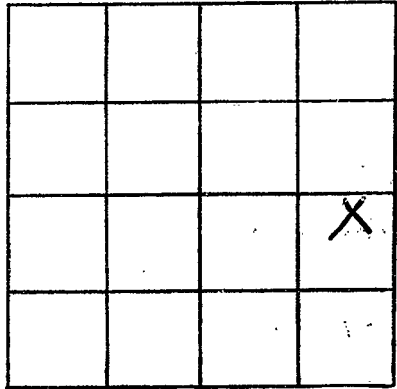

SECTION 31

Please indicate well location X.

ADDITIONAL INFORMATION

Supply well for
Plant well #1

If more than one screen,
show locations of each on sketch.