

Stone
C 31
2-12-70

MISSISSIPPI
BOARD OF WATER COMMISSIONERS
416 North State Street
Jackson, Mississippi 39201

CODED

WATER WELL DRILLERS LOG

2-12 1970 Parwell Anderson Stone
date well completed firm name county well located

LANDOWNER:	description of formations encountered	from	to
Laura Simpson	Top Soil	0	5
Wiggins Miss	Red Clay	5	35
	Red Sand	35	60
	Red Clay	60	85
	Sand	85	120
	Red Clay	120	134
	Coarse Sand	134	144

(mailing address)

WELL LOCATION:
sec. 28 T. 2 R. 11
3 miles E of Wiggins
(distance) (direction) (nearest town)

WELL PURPOSE:
(home, irrigation, municipal, industrial)

WELL COMPLETION DATA:

(1) diameter (inches) ~~12~~ 2

(2) total depth (feet) 144

(3) static water level (feet) 60 below top of ground.

(4) casing Plastic (material), (depth) (size) if telescope see back.

(5) screen 6' 138 (length) (depth to top) 2" Plastic (size) (material)

(6) pump 1 (HP) 7 (yield gpm) Elect (type power)

(7) electric log (yes or no)
(organization running log)


(8) how well bottom plugged

DRILLERS REMARKS:

MAR 6 - 1970
MISS. BD. OF WATER COMMS

If well telescopes please sketch and show depths.

GROUND LEVEL

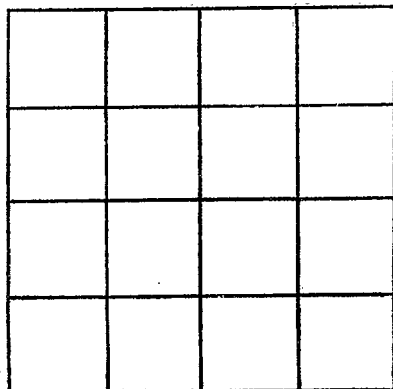

SECTION _____

Please indicate well location X.

ADDITIONAL INFORMATION

If more than one screen, show locations of each on sketch.