

Stone
 C33
 5/22/69

MISSISSIPPI
 BOARD OF WATER COMMISSIONERS
 416 North State Street
 Jackson, Mississippi 39201

CODED

WATER WELL DRILLERS LOG

5-22 1969 L W Smith Stone
 date well completed firm name county well located

LANDOWNER:	description of formations encountered	from	to
Dan Breland			
Wiggins (mailing address)	Clay Sand Clay	1	22
		22	58

WELL LOCATION:
 sec. 26 T 2 R 11 S W
 9 miles SE of Wiggins
 (distance) (direction) (nearest town)

WELL PURPOSE:
 (home, irrigation, municipal, industrial)

- WELL COMPLETION DATA:
- (1) diameter (inches) 2"
 - (2) total depth (feet) 58'
 - (3) static water level (feet) 35' above top of ground.
 - (4) casing Plastic 53'
 (material) (depth)
 (size) if telescope see back.
 - (5) screen 5' 53'
 (length) (depth to top)
 (size) (material)
 - (6) pump 1/2 5
 (HP) (yield gpm)
 Electric
 (type power)
 - (7) electric log (yes or no)
 - (organization running log)
 - (8) how well bottom plugged BW

CODED


JUL 30 1969

DRILLERS REMARKS:

MISS. BD. OF
 WATER COMM.

If well telescopes please sketch and show depths.

GROUND LEVEL

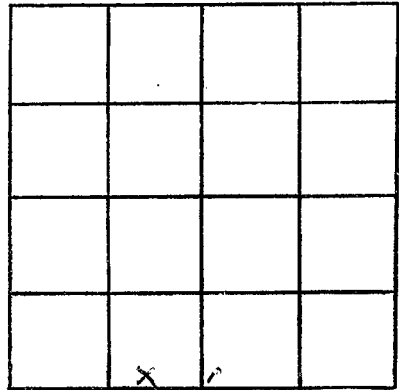

SECTION _____

Please indicate well location X.

ADDITIONAL INFORMATION

If more than one screen,
show locations of each on sketch.