

STONE
C 35
8-19-70

MISSISSIPPI
BOARD OF WATER COMMISSIONERS
416 North State Street
Jackson, Mississippi 39201

CODED

WATER WELL DRILLERS LOG

8/19 1970 date well completed
SBR firm name
Stone county well located

LANDOWNER: Mr. O. M. Nelson

description of formations encountered from to

RT 1
Wiggins, Miss (mailing address)

Early clay	0	31
White clay	31	90
Brown + Blue Shale	90	137
Blue clay clay	137	211
Sand Sand	211	238
Hard thin clay	238	361
C. & B. Sand	361	376

WELL LOCATION:
sec. 5 T 2 N R 11 E
2 miles NE of Wiggins (distance) (direction) (nearest town)

WELL PURPOSE: Farm
(home, irrigation, municipal, industrial)

WELL COMPLETION DATA:

- (1) diameter (inches) 4X2
- (2) total depth (feet) 276
- (3) static water level (feet) 197 below top of ground.
- (4) casing 4X2 (material), 261 (depth)
- 4X2 (size) if telescope see back.
- (5) screen 15 (length), 261 (depth to top)
- 2" (size), S/S (material)
- (6) pump 1 1/2 (HP), 26 (yield gpm)
- Subc (type power)
- (7) electric log (yes or no)
- (organization running log)
- (8) how well bottom plugged blue

CODED

OCT 12 1970

DRILLERS REMARKS:

MISS. RD. OF
WATER BOARD

If well telescopes please sketch and show depths.


GROUND LEVEL

4" Casag
252 ft

4x2
sand pack

25 ft
2" Galv pipe

3-5 ft
2" O10
S/S Screen

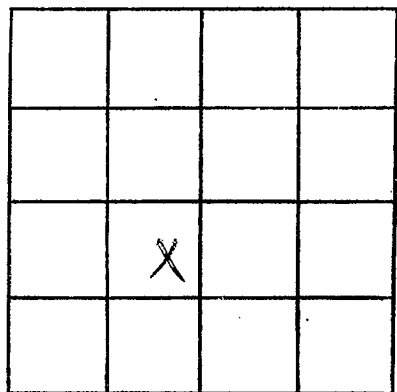

SECTION 5

Please indicate well location X.

ADDITIONAL INFORMATION

If more than one screen,
show locations of each on sketch.