

STONE
C38
3-10-71

MISSISSIPPI
BOARD OF WATER COMMISSIONERS
416 North State Street
Jackson, Mississippi 39201

CODED

WATER WELL DRILLERS LOG

3-10 1971 LeW Smith Stone
date well completed firm name county well located

LANDOWNER:
Berwenia Sadner
Wiggins Route
(mailing address)

| description of formations encountered | from | to |
|---------------------------------------|-----------|------------|
| <u>Top Soil</u> | <u>0</u> | <u>2</u> |
| <u>Clay</u> | <u>2</u> | <u>78</u> |
| <u>Sand</u> | <u>78</u> | <u>110</u> |

WELL LOCATION:
sec. 33 T 2 R 11
3 miles S-E of WIGGINS
(distance) (direction) (nearest town)

WELL PURPOSE:
(home, irrigation, municipal, industrial)

- WELL COMPLETION DATA:
- (1) diameter (inches) 2
 - (2) total depth (feet) 110
 - (3) static water level (feet) 72 below above top of ground.
 - (4) casing Plastic 105
(material) (depth)
(size) if telescope see back.
 - (5) screen 5' 105
(length) (depth to top)
(size) (material)
 - (6) pump 1 10
(HP) (yield gpm)
E
(type power)
 - (7) electric log _____
(yes or no)
(organization running log)
 - (8) how well bottom plugged cab

CODED


APR 19 1971

MISS. BD. OF
WATER COM.

DRILLERS REMARKS:

If well telescopes please sketch and show depths.

GROUND LEVEL

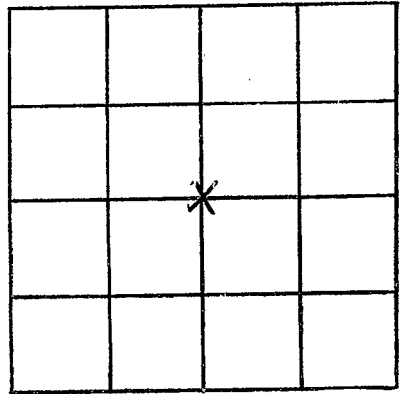

SECTION _____

Please indicate well location X.

ADDITIONAL INFORMATION

If more than one screen, show locations of each on sketch.