

STONE  
C 39  
2-3-71

MISSISSIPPI  
BOARD OF WATER COMMISSIONERS  
416 North State Street  
Jackson, Mississippi 39201

**CODED**

WATER WELL DRILLERS LOG

2-3 1971 Parnee Anderson Stone  
date well completed firm name county well located

LANDOWNER: Odell Brelance  
Rt  
Wiggins, Miss  
(mailing address)

description of fomations encountered	from	to
TOP Soil	0	2
Red Sand clay	2	18
Fine Red Sand	18	30
Red Clay	30	70
Fine Sand	70	80
Coarse Sand	80	89

WELL LOCATION:  
sec. 4 T. 2 N. R. 11 E  
S W  
4 miles E of Wiggins  
(distance) (direction) (nearest town)

WELL PURPOSE: Home  
(home, irrigation, municipal, industrial)

- WELL COMPLETION DATA:
- (1) diameter (inches) 2"
  - (2) total depth (feet) 89
  - (3) static water level (feet) 62 below above top of ground.
  - (4) casing Plastic 83  
(material) (depth)  
(size) if telescope see back.
  - (5) screen 6' 83  
(length) (depth to top)  
2" Plastic  
(size) (material)
  - (6) pump 1 8  
(HP) (yield gpm)  
Electric  
(type power)
  - (7) electric log no  
(yes or no)  
(organization running log)
  - (8) how well bottom plugged Backwash valve

**CODED**


JUN 3 1971

DRILLERS REMARKS:

MISS. BD. OF  
WATER COM.

If well telescopes please sketch and show depths.

GROUND LEVEL

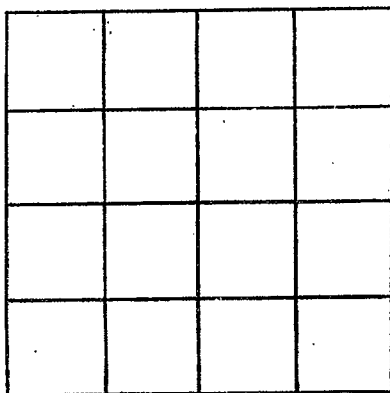

SECTION \_\_\_\_\_

Please indicate well location X.

ADDITIONAL INFORMATION

If more than one screen, show locations of each on sketch.