

STONE
C40
2-23-71

MISSISSIPPI
BOARD OF WATER COMMISSIONERS
416 North State Street
Jackson, Mississippi 39201

CODED

WATER WELL DRILLERS LOG

2-23 1971
date well completed

Parnell Anderson Stone
firm name

county well located

LANDOWNER: Dinal Truck Stop
Qt
(mailing address)

description of formations encountered	from to	
	feet	feet
Red clay	0	27
fine sand	27	34
Red clay	34	46
coarse sand & gravel	46	58

WELL LOCATION:
sec. 31 T. 2 N. R. 11 E
S W
2 miles S of Wiggins
(distance) (direction) (nearest town)

WELL PURPOSE: Business
(home, irrigation, municipal, industrial)

- WELL COMPLETION DATA:
- (1) diameter (inches) 2"
 - (2) total depth (feet) 58
 - (3) static water level (feet) 26 below above top of ground.
 - (4) casing 2" (material) 52' (depth)
2" (size) if telescope see back.
 - (5) screen 6' (length) 52' (depth to top)
2" (size) Plastic (material)
 - (6) pump 1 (HP) 10 (yield gpm)
Electric (type power)
 - (7) electric log No (yes or no)
- (organization running log)

CODED


JUN 2 1971

DRILLERS REMARKS:
Gas brush valve

MISS. BD. OF
WATER COMMISSIONERS

If well telescopes please sketch and show depths.

GROUND LEVEL

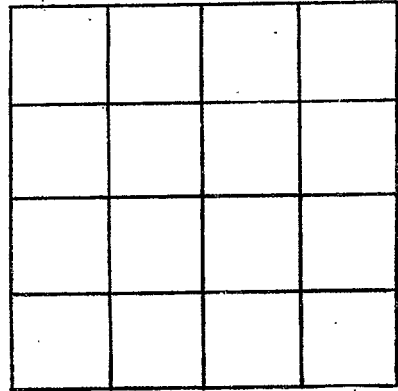

SECTION _____

Please indicate well location X.

ADDITIONAL INFORMATION

If more than one screen, show locations of each on sketch.