

STONE  
C 41  
3-20-71

MISSISSIPPI  
BOARD OF WATER COMMISSIONERS  
416 North State Street  
Jackson, Mississippi 39201

**CODED**

WATER WELL DRILLERS LOG

3-20 19 71 Parnee Anderson Stone  
date well completed firm name county well located

LANDOWNER: Stone High School  
Wiggins, Miss.  
(mailing address)

description of formations encountered	from	to
Red Clay	0	28
Fine Sand	28	43
Red Clay	43	68
Fine Sand	68	102
Coarse Sand	102	118

WELL LOCATION:  
sec. 29 T 2 N R 11 E  
S W  
(distance) miles (direction) of (nearest town)

WELL PURPOSE:  
(home, irrigation, municipal, industrial)

- WELL COMPLETION DATA:
- (1) diameter (inches) 2"
  - (2) total depth (feet) 112'
  - (3) static water level (feet) 40' below above top of ground.
  - (4) casing 2' (material), 112' (depth), (size) If telescope see back.
  - (5) screen 6' (length), 112' (depth to top), 2' (size), Plastic (material)
  - (6) pump 1 (HP), 9 (yield gpm), (type power)
  - (7) electric log no (yes or no), (organization running log)

**CODED**

(8) how well bottom plugged Backwash Valve


DRILLERS REMARKS:

JUN 3 1971

MISS. BD. OF WATER COMMISSIONERS

If well telescopes please sketch and show depths.

GROUND LEVEL

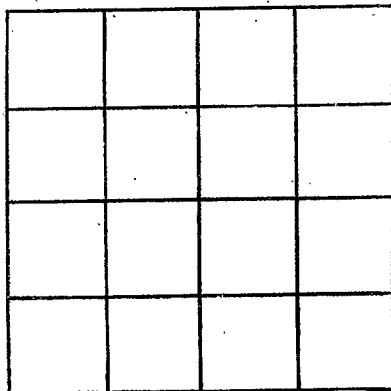

SECTION \_\_\_\_\_

Please indicate well location X.

ADDITIONAL INFORMATION

If more than one screen, show locations of each on sketch.