

MISSISSIPPI
BOARD OF WATER COMMISSIONERS
416 North State Street
Jackson, Mississippi 39201

CODED

WATER WELL DRILLERS LOG

STONE
C42
5-7-70

5-7 1970 Farnell Anderson Stone
date well completed firm name county well located

LANDOWNER: NE Alexander
Wiggins
Wiggins
(mailing address)

WELL LOCATION:
sec. 34 T 2 S R. 11 E W
4 miles E of Wiggins
(distance) (direction) (nearest town)

WELL PURPOSE: Home
(home, irrigation, municipal, industrial)

description of formations encountered	from	to
TOP Soil	0	2
Red Clay	2	19
Fine Sand	19	26
White Clay	26	66
Fine Sand	66	78
Red Clay	78	84
Fine Sand	84	98
Red Clay	98	106
Coarse Sand	106	127

WELL COMPLETION DATA:

(1) diameter (inches) 2

(2) total depth (feet) 127

(3) static water level (feet) 85 below top of ground.

(4) casing Plastic, 121
(material) (depth)

(size) if telescope see back.

(5) screen 6, 121
(length) (depth to top)

2", Plastic
(size) (material)

(6) pump 1, 6
(HP) (yield gpm)

Floet
(type power)

(7) electric log _____
(yes or no)

(organization running log)

(8) how well bottom plugged? Back Wash Valve

CODED


JUN 11 1971

DRILLERS REMARKS:

MISS. BD. OF
WATER COMM.

If well telescopes please sketch and show depths.

GROUND LEVEL

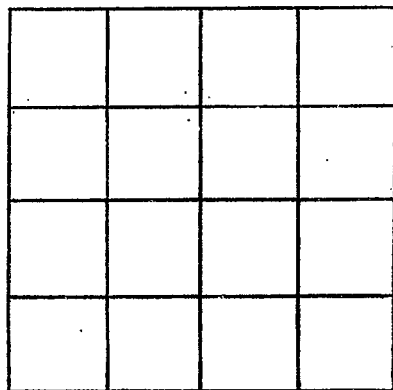

SECTION _____

Please indicate well location X.

ADDITIONAL INFORMATION

If more than one screen,
show locations of each on sketch.