

STONE  
C43  
7-11-70

MISSISSIPPI  
BOARD OF WATER COMMISSIONERS  
416 North State Street  
Jackson, Mississippi 39201

**CODED**

WATER WELL DRILLERS LOG

7-11  
date well completed

1970 Parnell Anderson  
firm name

Stone  
county well located

LANDOWNER: Earl G. Farnham  
Wiggins  
(mailing address)

description of formations encountered	from	to
TOP Soil	0	3
Red Clay	3	21
Fine Sand	21	28
Red Clay	28	52
Blue Sand	52	86
Red Clay	86	91
Coarse Clay	91	112

WELL LOCATION:  
sec. 31 T 2 R 11  
S W  
2 miles S of Wiggins  
(distance) (direction) (nearest town)

WELL PURPOSE: Home  
(home, irrigation, municipal, industrial)

- WELL COMPLETION DATA:
- (1) diameter (inches) 4"
  - (2) total depth (feet) 112
  - (3) static water level (feet) 50 below above top of ground.
  - (4) casing Plastic, 104  
(material) (depth)
  - (size) if telescope see back.
  - (5) screen 8", 104  
(length) (depth to top)  
4", Plastic  
(size) (material)
  - (6) pump 3/4 12  
(HP) (yield gpm)  
Elect  
(type power)
  - (7) electric log (yes or no)
  - (organization running log)
  - (8) how well bottom plugged Back Wash

**CODED**


JUN 11 1971

MISS. BD. OF  
WATER COMMISSIONERS

DRILLERS REMARKS:

If well telescopes please sketch and show depths.

GROUND LEVEL

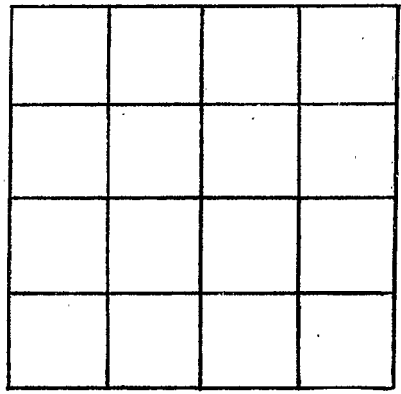

SECTION \_\_\_\_\_

Please indicate well location X.

ADDITIONAL INFORMATION

A series of horizontal lines for recording additional information.

If more than one screen, show locations of each on sketch.