

STONE
C 44
8-18-70

MISSISSIPPI
 BOARD OF WATER COMMISSIONERS
 416 North State Street
 Jackson, Mississippi 39201

CODED

WATER WELL DRILLERS LOG

8-18 date well completed 70 Barwell Anderson firm name Stone county well located


LANDOWNER: <u>Calvin Broland</u>	description of formations encountered	from	to
<u>Wiggins Miss</u> (mailing address)	<u>TOP Soil</u>	<u>0</u>	<u>3</u>
	<u>Red Clay</u>	<u>3</u>	<u>38</u>
	<u>lime Sand</u>	<u>38</u>	<u>47</u>
	<u>Red clay</u>	<u>47</u>	<u>103</u>
	<u>Coarse Sand</u>	<u>103</u>	<u>126</u>
WELL LOCATION: sec <u>25</u> T <u>2</u> S R <u>11</u> W <u>8</u> miles <u>E</u> of <u>Wiggins</u> (distance) (direction) (nearest town)			
WELL PURPOSE: <u>Home</u> (home, irrigation, municipal, industrial)			
WELL COMPLETION DATA:			
(1) diameter (inches) <u>2</u>			
(2) total depth (feet) <u>126</u>			
(3) static water level (feet) <u>40</u> below above top of ground.			
(4) casing <u>Plastic</u> , <u>120</u> , (material) (depth)			
_____ (size) if telescope see back.			
(5) screen <u>6'</u> , <u>120</u> (length) (depth to top)			
<u>2"</u> , <u>Plastic</u> (size) (material)			
(6) pump <u>1/2</u> <u>5</u> (HP) (yield gpm)			
_____ (type power)			
(7) electric log _____ (yes or no)			
_____ (organization running log)			
(8) how well bottom plugged: <u>Backwash Valve</u>			
DRILLERS REMARKS: _____ _____ _____			

CODED

JUN 11 1971

If well telescopes please sketch and show depths.

GROUND LEVEL

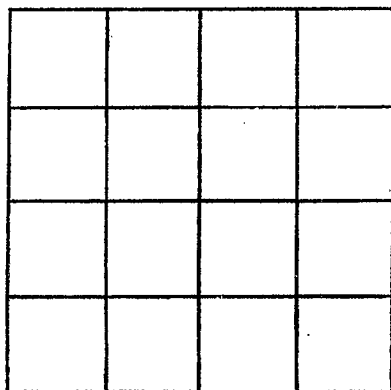

SECTION _____

Please indicate well location X.

ADDITIONAL INFORMATION

If more than one screen,
show locations of each on sketch.