

STONE
C45
9-1-70

MISSISSIPPI
BOARD OF WATER COMMISSIONERS
416 North State Street
Jackson, Mississippi 39201

CODED

WATER WELL DRILLERS LOG

9-1
date well completed

1970 Parnell Anderson
firm name

Stovie
county well located

LANDOWNER: C.A. Thompson
Wiggins
(mailing address)

description of formations encountered	from	to
Top Soil	0	2
Red Sand	2	26
Red Clay	26	59
Fine Sand	59	70
Pink Clay	70	73
Coarse Sand	73	85

WELL LOCATION:
sec. 29 T 2 R 11 E
S W
5 miles E of Wiggins
(distance) (direction) (nearest town)

WELL PURPOSE: Home
(home, irrigation, municipal, industrial)

WELL COMPLETION DATA:

(1) diameter (inches) 2

(2) total depth (feet) 85

(3) static water level (feet) 54 below ~~surface~~ top of ground.

(4) casing Plastic, 79
(material) (depth)
(size) if telescope see back.

(5) screen 6, 79
(length) (depth to top)
2", Plastic
(size) (material)

(6) pump 1, 10
(HP) (yield gpm)
Elect
(type power)

(7) electric log _____
(yes or no)
(organization running log)

(8) how well bottom plugged
Backwash valve

CODED


JUN 11 1971

DRILLERS REMARKS:

MISS. Bd. OF
WATER COMMISSIONERS

If well telescopes please sketch and show depths.

GROUND LEVEL

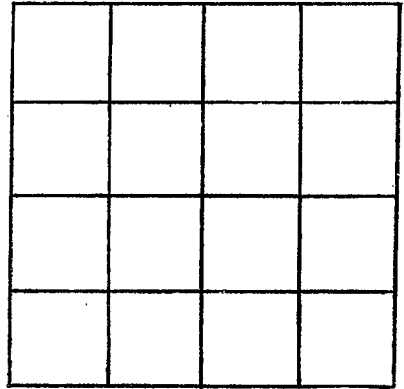

SECTION _____

Please indicate well location X.

ADDITIONAL INFORMATION

If more than one screen,
show locations of each on sketch.