

Stone
C-46
6-7-71

MISSISSIPPI
BOARD OF WATER COMMISSIONERS
416 North State Street
Jackson, Mississippi 39201

CODED

WATER WELL DRILLERS LOG

6-7 1971 Perwell Awders Stone
date well completed firm name county well located

LANDOWNER: Roy Lott
Wiggins Miss
(mailing address)

description of formations encountered	from	to
TOPSOIL	0	2
Red sand clay	2	19
Red Sand	19	39
Red Clay	32	74
Sand with clay streak	74	106
Coarse Sand	106	126

WELL LOCATION:
sec. 34 T. 2 N. R. 11 W.
4 miles E of Wiggins
(distance) (direction) (nearest town)

WELL PURPOSE:
(home, irrigation, municipal, industrial)


- WELL COMPLETION DATA:
- (1) diameter (inches) 2
 - (2) total depth (feet) 126
 - (3) static water level (feet) 75 below top of ground.
 - (4) casing Plastic, 120 (material) (depth)
 - (size) if telescope see back.
 - (5) screen 6 (length), 120 (depth to top)
 - 2 (size), Plastic (material)
 - (6) pump 1 (HP), 9 (yield gpm)
 - (type power)
 - (7) electric log (yes or no)
 - (organization running log)
 - (8) how well bottom plugged Back Wash Valve

DRILLERS REMARKS:

AUG 20 1971

If well telescopes please sketch and show depths.

GROUND LEVEL

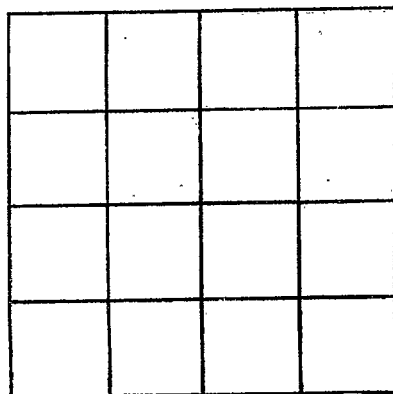

SECTION _____

Please indicate well location X.

ADDITIONAL INFORMATION

If more than one screen, show locations of each on sketch.