

**CODED**

MISSISSIPPI  
BOARD OF WATER COMMISSIONERS  
416 North State Street  
Jackson, Mississippi 39201

MAR 9 1972

STONE  
C47  
1-11-72

WATER WELL DRILLERS LOG

1-11-1972 Neil Lumpkin Well Stone  
date well completed firm name county well located  
Pulling Service

LANDOWNER: Cinder Farm  
Paul Hayes  
Wiggins, Miss.  
  
(mailing address)  
  
WELL LOCATION:  
sec. 12 T. 2 R. 11  
5 miles NE of Wiggins  
(distance) (direction) (nearest town)

description of formations encountered	from	to
<u>Surface clay</u>	<u>0</u>	<u>20</u>
<u>fine sand,</u> <u>fine to better</u>	<u>20</u>	<u>86</u>

WELL PURPOSE: home  
(home, irrigation, municipal, industrial)

- WELL COMPLETION DATA:
- (1) diameter (inches) 2"
  - (2) total depth (feet) 86
  - (3) static water level (feet) 30 below above top of ground.
  - (4) casing plastic (material) (depth) 2" (size) If telescope see back.
  - (5) screen 6' (length) (depth to top) 2" (size) plastic (material)
  - (6) pump 1 (HP) 450 gph (yield gpm)  
electric (type power)
  - (7) electric log No (yes or no)


**CODED**

(organization running log)  
  
(8) how well bottom plugged Johnson  
B. P. Plabre

DRILLERS REMARKS: 1

If well telescopes please sketch and show depths.

GROUND LEVEL

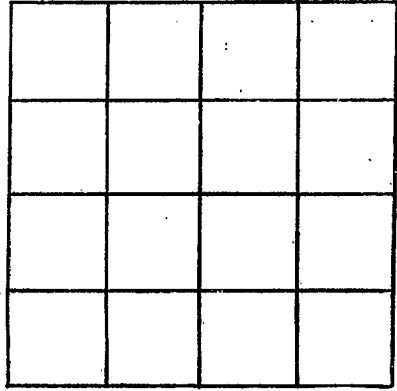

SECTION \_\_\_\_\_

Please indicate well location X.

ADDITIONAL INFORMATION

If more than one screen,  
show locations of each on sketch.