

STONE
C 48
10-4-71

MISSISSIPPI
BOARD OF WATER COMMISSIONERS
416 North State Street
Jackson, Mississippi 39201

CODED

WATER WELL DRILLERS LOG

10-4 1971 Parnell Anderson Stone
date well completed firm name county well located

LANDOWNER: Eva Baker

Rt 1 Perkinston

(mailing address)

WELL LOCATION:

sec. 36 T. 2 R. 11 S. W
7 miles W of Wiggins
(distance) (direction) (nearest town)

WELL PURPOSE: Home
(home, irrigation, municipal, industrial)

WELL COMPLETION DATA:

- (1) diameter (inches) 2
- (2) total depth (feet) 137
- (3) static water level (feet) 58 below above top of ground.
- (4) casing PVC, 131
(material) (depth)
 if telescope see back.
(size)
- (5) screen 6, 131
(length) (depth to top)
2, PVC
(size) (material)
- (6) pump 1, 9
(HP) (yield gpm)
Elec
(type power)
- (7) electric log
(yes or no)

(organization running log)
- (8) how well bottom plugged
Backwash Valve

description of formations encountered

from to

TOP Soil	0	4
Red Sandy Clay	4	26
Fine Sand	26	49
Red Clay	49	57
Fine Sand with chys	57	120
Coarse Sand	120	137


CODED

DRILLERS REMARKS:

DEC 8 1972

If well telescopes please sketch and show depths.

GROUND LEVEL

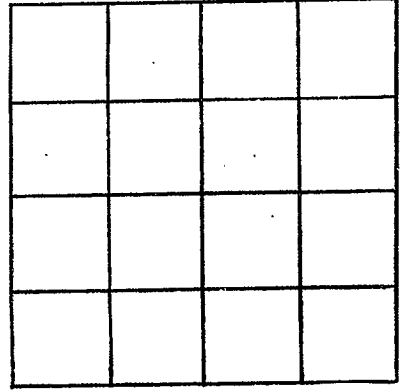

SECTION _____

Please indicate well location X.

ADDITIONAL INFORMATION

If more than one screen, show locations of each on sketch.