

MISSISSIPPI  
BOARD OF WATER COMMISSIONERS  
416 North State Street  
Jackson, Mississippi 39201

**CODED**

WATER WELL DRILLERS LOG

STONE  
C 49  
2-10-72

2-10 1972 Fornell Anderson Stone  
date well completed firm name county well located

LANDOWNER: Pat Harrison Waterway

description of formations encountered

from to

P.O. Drawer 1509 Hattiesburg  
Miss 39401  
(mailing address)

Top Soil	0	3
Sandy Clay	3	19
Fine Sand	19	24
Red Clay	24	35
Coarse Sand	35	49

WELL LOCATION:

sec. 7 T. 2 N. R. 11 E.  
S. W.  
1 1/2 miles N-E of Wiggins  
(distance) (direction) (nearest town)

WELL PURPOSE: CAMP SITE  
(home, irrigation, municipal, industrial)

WELL COMPLETION DATA:

**CODED**


- (1) diameter (inches) 3
- (2) total depth (feet) 49
- (3) static water level (feet) 20 below  
top of ground. above
- (4) casing Galvne 38  
(material) (depth)  
           if telescope see back.  
(size)
- (5) screen 5' 38  
(length) (depth to top)  
2" Plastic  
(size) (material)
- (6) pump Hand 1-4  
(HP) (yield gpm)  
Hand  
(type power)
- (7) electric log             
(yes or no)  
            
(organization running log)
- (8) how well bottom plugged  
Backwash Valve

DRILLERS REMARKS:

DRG 11 1972

If well telescopes please sketch and show depths.

GROUND LEVEL

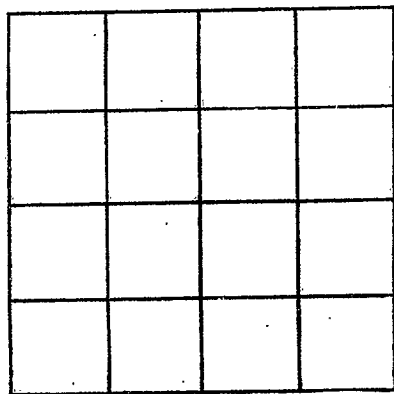

SECTION \_\_\_\_\_

Please indicate well location X.

ADDITIONAL INFORMATION

If more than one screen,  
show locations of each on sketch.