

**CODED**

MISSISSIPPI  
BOARD OF WATER COMMISSIONERS  
416 North State Street  
Jackson, Mississippi 39201

WATER WELL DRILLERS LOG

STONE  
C 50  
12-11-72

12-11-72 19 Pamell Anderson Stone  
date well completed firm name county well located

LANDOWNER: Allen Evans

| description of formations encountered | from      | to         |
|---------------------------------------|-----------|------------|
| <u>Top Soil</u>                       | <u>0</u>  | <u>4</u>   |
| <u>Red Clay</u>                       | <u>4</u>  | <u>18</u>  |
| <u>Sandy Clays</u>                    | <u>18</u> | <u>30</u>  |
| <u>Fine Sand</u>                      | <u>30</u> | <u>85</u>  |
| <u>Coarse Sand</u>                    | <u>85</u> | <u>100</u> |

RTA  
(mailing address)

WELL LOCATION:

sec 2 T N R 11 E  
8 " S W  
8 miles S-E of Wiggins  
(distance) (direction) (nearest town)

WELL PURPOSE: Home Use  
(home, irrigation, municipal, industrial)

WELL COMPLETION DATA:

- (1) diameter (inches) 4"
- (2) total depth (feet) 105
- (3) static water level (feet) 48 below above top of ground.
- (4) casing Plastic, 100  
(material) (depth)
- \_\_\_\_\_ if telescope see back.  
(size)
- (5) screen 5', 100  
(length) (depth to top)
- 2", Plastic  
(size) (material)
- (6) pump 1, 9  
(HP) (yield gpm)
- Elect.  
(type power)
- (7) electric log no  
(yes or no)

**CODED**

(organization running log)


(8) how well bottom plugged  
Back wash valve

MAY 25 1973

DRILLERS REMARKS: Good well

If well telescopes please sketch and show depths.

GROUND LEVEL

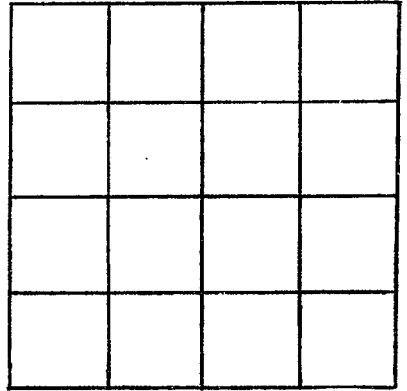

SECTION \_\_\_\_\_

Please indicate well location X.

ADDITIONAL INFORMATION

If more than one screen, show locations of each on sketch.