

STONE
C 52
6-12-73

MISSISSIPPI
BOARD OF WATER COMMISSIONERS
416 North State Street
Jackson, Mississippi 39201

WATER WELL DRILLERS LOG

CODED

6-12 1973
date well completed

Parnell Anderson
firm name

Steno
county well located

LANDOWNER:

Ray Bryant
Wiggins
(mailing address)

description of formations encountered

from

to

WELL LOCATION:

sec. 17 T 2 S R 11 E W
3 miles NE of Wiggins
(distance) (direction) (nearest town)

Top Soil	0	4
Dark Clay	4	16
White Clay	16	36
Fine Sand	46	85
Medium Sand	85	118

WELL PURPOSE:

HOME
(home, irrigation, municipal, industrial)

WELL COMPLETION DATA:

- (1) diameter (inches) 2"
- (2) total depth (feet) 118'
- (3) static water level (feet) 70' below top of ground.
- (4) casing Plastic, 113'
(material) (depth)
if telescope see back.
(size)
- (5) screen 5' , 113'
(length) (depth to top)
2" Plastic
(size) (material)
- (6) pump 1 HP , 8
(yield gpm)
Electricity
(type power)
- (7) electric log no
(yes or no)
(organization running log)


(8) how well bottom plugged
Back with valve

DRILLERS REMARKS:

NOV 5 1973

If well telescopes please sketch and show depths.

GROUND LEVEL

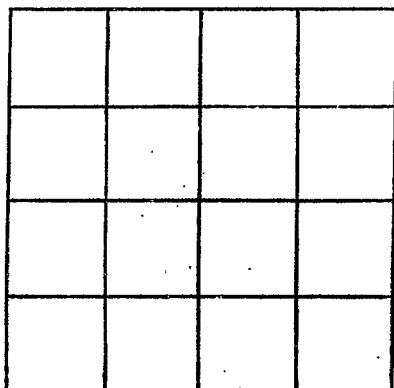

SECTION _____

Please indicate well location X.

ADDITIONAL INFORMATION

If more than one screen,
show locations of each on sketch.