

STONE  
C 53  
6-28-73

MISSISSIPPI  
BOARD OF WATER COMMISSIONERS  
416 North State Street  
Jackson, Mississippi 39201

WATER WELL DRILLERS LOG

CODED

6-28-73 date well completed  
1973 Parnell Anderson firm name  
Stone county well located

LANDOWNER: J. E. Manis  
Wiggins  
(mailing address)

WELL LOCATION:  
sec 23 T 2 S R 11 E W  
4 miles E of Wiggins  
(distance) (direction) (nearest town)

WELL PURPOSE: HOME  
(home, irrigation, municipal, industrial)

- WELL COMPLETION DATA:
- (1) diameter (inches) 2"
  - (2) total depth (feet) 108'
  - (3) static water level (feet) 50' below top of ground.
  - (4) casing Plastic, 103' (material) (depth)
  - \_\_\_\_\_ if telescope see back. (size)
  - (5) screen 5' length, 103' depth to top  
8" Plastic (size) (material)
  - (6) pump 1 (HP), 22 (yield gpm)  
Electric (type power)
  - (7) electric log no (yes or no)
  - \_\_\_\_\_ (organization running log)
  - (8) how well bottom plugged Backwash valve


description of formations encountered	from	to
	Top Soil	0
Pin Clay	4	23
White Clay	23	66
Thin Sand	66	84
Course Sand	84	108

DRILLERS REMARKS:

NOV 5 1973

If well telescopes please sketch and show depths.

GROUND LEVEL

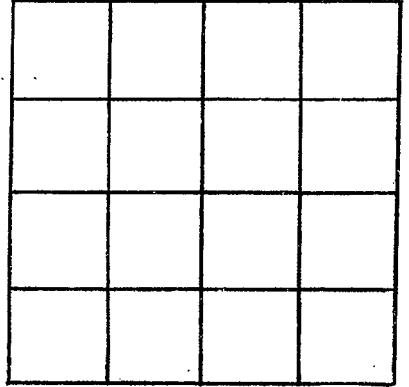

SECTION \_\_\_\_\_

Please indicate well location X.

ADDITIONAL INFORMATION

If more than one screen,  
show locations of each on sketch.