

STONE
C56
8-10-73

MISSISSIPPI
BOARD OF WATER COMMISSIONERS
416 North State Street
Jackson, Mississippi 39201
WATER WELL DRILLERS LOG

8-10 1973 Parnell Anderson Stone
date well completed firm name county well located

LANDOWNER:
Wiley H. Knight
W. Leggins
(mailing address)

description of formations encountered	from	to
<u>Top Soil</u>	<u>0</u>	<u>6</u>
<u>Red Clay</u>	<u>6</u>	<u>24</u>
<u>Fine Sand</u>	<u>24</u>	<u>100</u>
<u>Coarse Sand</u>	<u>100</u>	<u>128</u>

WELL LOCATION:
sec. 17 T. 2 R. 21
S. W.
1 miles NE of W. Leggins
(distance) (direction) (nearest town)

WELL PURPOSE: HOME
(home, irrigation, municipal, industrial)

CODED

WELL COMPLETION DATA:

(1) diameter (inches) 2"

(2) total depth (feet) 128'

(3) static water level (feet) 80' below top of ground.

(4) casing Plaster, 123'
(material) (depth)

_____ if telescope see back.
(size)

(5) screen 5', 123'
(length) (depth to top)

2", Plaster
(size) (material)

(6) pump 1, 9
(HP) (yield gpm)

Electricity
(type power)

(7) electric log no
(yes or no)


_____ (organization running log)

(8) how well bottom plugged
backwash valve

DRILLERS REMARKS:

If well telescopes please sketch and show depths.

GROUND LEVEL

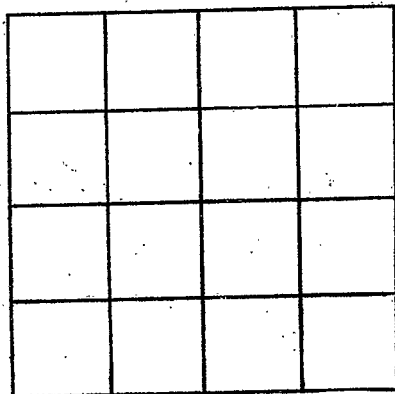

SECTION _____

Please indicate well location X.

ADDITIONAL INFORMATION

If more than one screen,
show locations of each on sketch.