

STONE
C 57
10-26-73

MISSISSIPPI
 BOARD OF WATER COMMISSIONERS
 416 North State Street
 Jackson, Mississippi 39201

CODED

WATER WELL DRILLERS LOG

10-26 1973
 date well completed

Pennell Anderson
 firm name

Stone
 county well located

LANDOWNER:
Francis Stone
Wiggins miss
 (mailing address)

description of formations encountered	from	to
<i>Top Soil</i>	<i>0</i>	<i>4 1/2</i>
<i>Bank Clay</i>	<i>4 1/2</i>	<i>18</i>
<i>Fine Sand</i>	<i>18</i>	<i>62</i>
<i>Coarse Sand</i>	<i>62</i>	<i>82</i>

WELL LOCATION:
 sec. *19* T. *20* R. *44*
1 miles *N* of *Wiggins*
 (distance) (direction) (nearest town)

WELL PURPOSE: *HOME*
 (home, irrigation, municipal, industrial)

- WELL COMPLETION DATA:
- (1) diameter (inches) *2"*
 - (2) total depth (feet) *82'*
 - (3) static water level (feet) *45'* below top of ground.
 - (4) casing *Plastic*, *77'*
 (material) (depth)
 - _____ if telescope see back.
 (size)
 - (5) screen *5'*, *77'*
 (length) (depth to top)
 - 2"* *Plastic*
 (size) (material)
 - (6) pump *1* *10*
 (HP) (yield gpm)
 - Elect*
 (type power)
 - (7) electric log *no*
 (yes or no)
 - _____ (organization running log)
 - (8) how well bottom plugged
Backwash Valve


CODED

MISS. RD. OF
 WATER COMM.

DRILLERS REMARKS:

If well telescopes please sketch and show depths.

GROUND LEVEL

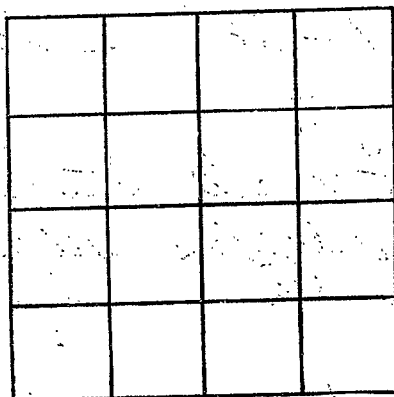

SECTION _____

Please indicate well location X.

ADDITIONAL INFORMATION

If more than one screen, show locations of each on sketch.