

STONE
C58
10-25-73

MISSISSIPPI
 BOARD OF WATER COMMISSIONERS
 416 North State Street
 Jackson, Mississippi 39201

CODED

WATER WELL DRILLERS LOG

10-25-73
 date well completed

1973 Donall Anderson
 firm name

Stone
 county well located

LANDOWNER:

Darry Alexander
Rt 2 Wiggins
 (mailing address)

description of formations encountered

from to

<u>Top Soil</u>	<u>0</u>	<u>3</u>
<u>Gravel Sand</u>	<u>3</u>	<u>20</u>
<u>Clayey Sand</u>	<u>40</u>	<u>63</u>

WELL LOCATION:

sec. 9 T. 2 S. R. 11 W.
2 miles NE of Wiggins
 (distance) (direction) (nearest town)

WELL PURPOSE: HOME
 (home, irrigation, municipal, industrial)

WELL COMPLETION DATA:

- (1) diameter (inches) 2"
- (2) total depth (feet) 63'
- (3) static water level (feet) 40' below above top of ground.
- (4) casing Plastic, 58'
 (material) (depth)

if telescope see back.
 (size)

- (5) screen 5', 58'
 (length) (depth to top)
2", Plastic
 (size) (material)

- (6) pump 1 10
 (HP) (yield gpm)
Elect
 (type power)

- (7) electric log NO
 (yes or no)

(organization running log)

- (8) how well bottom plugged
Backwash Valve

CODED


NOV 8 1973

MISS. BD. OF
 WATER COMM.

DRILLERS REMARKS:

If well telescopes please sketch and show depths.

GROUND LEVEL

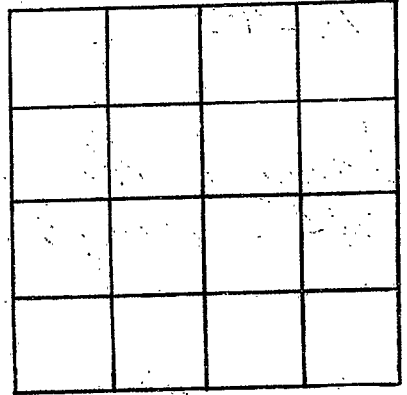

SECTION _____

Please indicate well location X.

ADDITIONAL INFORMATION

If more than one screen, show locations of each on sketch.