

STONE  
C 59  
12-18-73

MISSISSIPPI  
BOARD OF WATER COMMISSIONERS  
416 North State Street  
Jackson, Mississippi 39201

CODED

WATER WELL DRILLERS LOG

*Dannell Anderson Stone*

12-18 19  
date well completed

firm name

county well located

LANDOWNER:

*Dub Parsons*

*Rt 1 Wiggins*  
(mailing address)

description of formations encountered

*Top Soil*

from 0 to 4

*Fine Sand*

4 60

*Coarse Sand*

60 84

WELL LOCATION:

sec. *17* T *2* S R. *11* W  
*2* miles *N-E* of *Wiggins*  
(distance) (direction) (nearest town)

WELL PURPOSE: *HOME*  
(home, irrigation, municipal, industrial)

WELL COMPLETION DATA:

- (1) diameter (inches) *2"*
- (2) total depth (feet) *84'*
- (3) static water level (feet) *46'* below top of ground.
- (4) casing *Plastic*, *79'*  
(material) (depth)

CODED

if telescope see back.  
(size)

- (5) screen *5'*, *79'*  
(length) (depth to top)

*2"*, *Plastic*  
(size) (material)


- (6) pump *1*, *10*  
(HP) (yield gpm)

*Elect*  
(type power)

- (7) electric log *no*  
(yes or no)

(organization running log)


- (8) how well bottom plugged  
*Back wash valve*

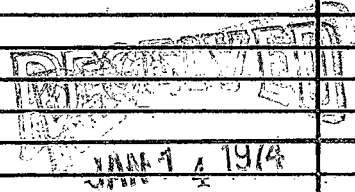

DRILLERS REMARKS:

If well telescopes please sketch and show depths.

GROUND-LEVEL

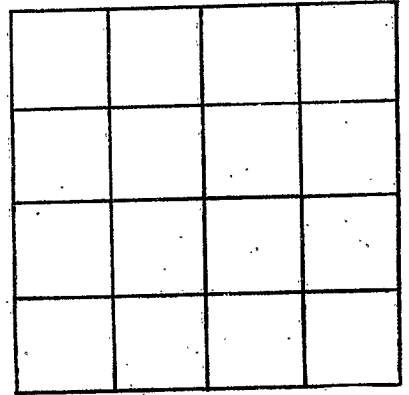

SECTION \_\_\_\_\_

Please indicate well location X.

ADDITIONAL INFORMATION

If more than one screen, show locations of each on sketch.

MISS. DR. OFF.  
DIVISION OF MINES  
JAN 1954